

CERTIFIED LAND CORNER RESTORATION

Index No. E-16

State of Wisconsin



County of Oneida } ss.

I, Phillip T. Hansen, do hereby certify that on the 9th day of November, 19 78, I found evidence of the E 1/16 corner of Section 3 & 10 Township 35, North, Range 10 East, Fourth Principal Meridian, as described hereon; and that from this evidence I established a new monument and accessories as described hereon to perpetuate the original location of this corner.

Resident witnesses:

Jim Clafin

Herb Wagoner

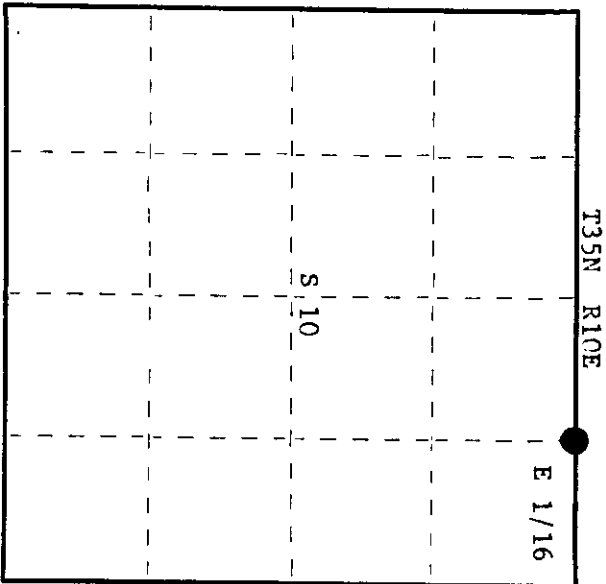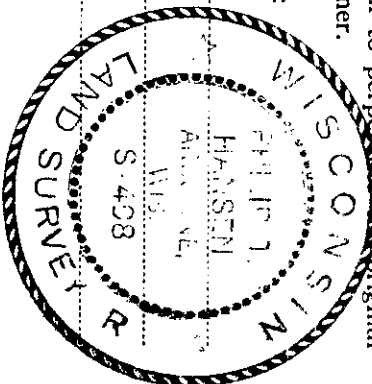

○ = Corner monument restored.

History of original corner establishment:

No records of any previous surveys. Corner established by N. Loftus, Ripco surveyor and H.C. Lawrence, Registered Land Surveyor, when they established the section corner 2, 3, 10 & 11 by double proportion. Set E 1/16 corner at point 60.31 chains west of section corner 2, 3, 10 and 11. Marked NBT - Maple 4" N38°W 41 links

Description of corner evidence found:

Recovered Ripco's 3/4" iron pipe with 2" square brass cap in excellent condition. Recovered OBT - Maple 4" (7") N38°W 41.0 links Monument projects 12" above ground, cap stamped:

T35N R10E
E 1/16 S 3
ST-10
RIPCO

Description of monument and accessories I established to perpetuate the original location of this corner. Left monument in place as recovered. Marked NBT - Maple 7" S74°W 58.3 links, scribed 1/16 BT

Dated at Rhineland, Wis., this 27th day of November, 19 78

Signature [Signature] Title Registered Land Surveyor Registration No. S-498
(County Surveyor, Registered Land Surveyor, or other duly authorized official)

Office of Register of Deeds, County of Oneida. I hereby certify that the within instrument was filed in this office for record on the 4th day of December, 19 78 at 1:35 o'clock P. M.

[Signature]
(Register of Deeds)

By [Signature] Deputy

3510030010