
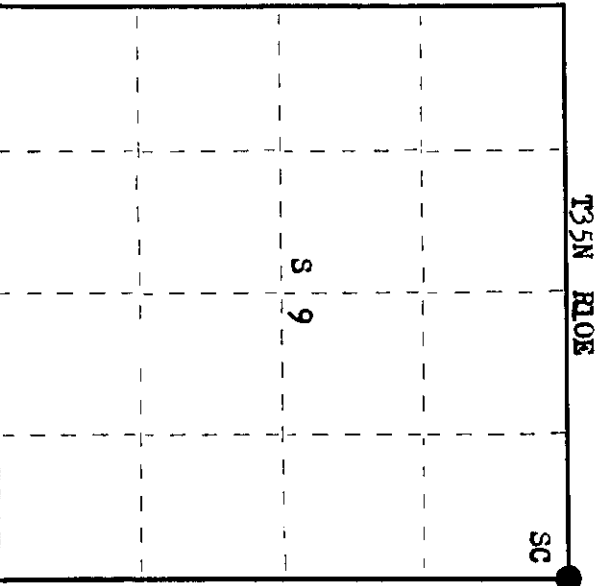


State of Wisconsin } ss.
County of Oneida

I Phillip R. Hansen, do hereby
certify that on the 8th day
of December, 1976, I found
evidence of the Section
corner of S3, 4, 9, 10
Township 35, North, Range
10, Fourth Principal Meridian,

as described hereon; and that from this evidence
I established a new monument and accessories
as described hereon to perpetuate the original
location of this corner.

Resident witnesses:
J. Clarlin
Herb Wagoner

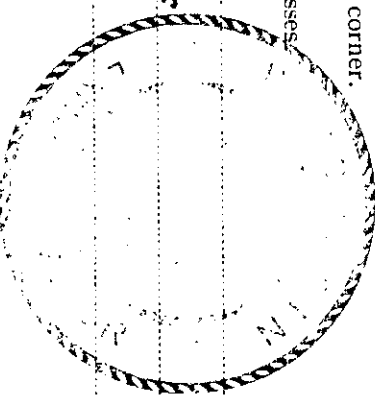

○ = Corner monument restored.

History of original corner establishment: Original Corner established by James L. Nowlin, Deputy Surveyor, in 1865, from which Tamarack 12" bears N 29° W 6 links, Tamarack 16" bears N 57° E 35 links.
Corner recovered by H.C. Lawrence, Registered Land Surveyor, in 1959. Recovered both of the original tamarack BFs, set new 4" cedar post and marked NBTs - Cedar 6" N 16° E 20½ links, Cedar 12" S 50° E 50½ links.
Goddard and crew, Ripco Surveyors, recovered corner in 1961 and set an iron pipe with 4" brass cap.

Description of corner evidence found:

Recovered Lawrence's 4" square cedar post, scribed S3, S4, S9, S10 and Ripco's 2" iron pipe with 4" square brass cap. Both corners laying down under fallen original Government BF, Tamarack 12" N 29° W 6 links.

Also recovered stump of tamarack 16" N 57° E 35 links, badly rotted but scribing partly visible.

Recovered OBT - Cedar 6" N 16° E 20.5 links, now stump, cut off above scribe marks.
Cedar 12" S 50° E 50.5 links, standing, green, scribed S10 NBT.

Description of monument and accessories I established to perpetuate the original location of this corner.

Reset Ripco's 2" iron pipe in old hole of Lawrence's post, cap stamped:

Monument projects 20" above ground.

NBTs - Cedar 6" N 41° E 50.3 links, scribed SC-BT.

Cedar 8" N 69° E 58.0 links, scribed SC-BT.



Dated at Rhinelander, Wis., this 16th day of February, 1977.

Signature Phillip R. Hansen Title Registered Land Surveyor Registration No. 5498
County Surveyor, Registered Land Surveyor, or other duly authorized official)

Office of Register of Deeds, County of Oneida
at 2:00 o'clock P. M. I hereby certify that the within
instrument was filed in this office for record on the 5th day of May, 1977.

Signature Doris Berge Kuehn
(Registrar of Deeds)

By..... Deputy

3510040000