

State of Wisconsin

County of Oneida } ss.


I, Phillip T. Hansen, do hereby certify that on the 21st day of June, 1977, I found evidence of the Section corner of Sec. 4, 5, 8, 9 Township 35, North, Range 10 East, Fourth Principal Meridian, as described hereon; and that from this evidence I established a new monument and accessories as described hereon to perpetuate the original location of this corner.

Resident witnesses:


Glen Barker

Jim Claflin

Herb Wagoner

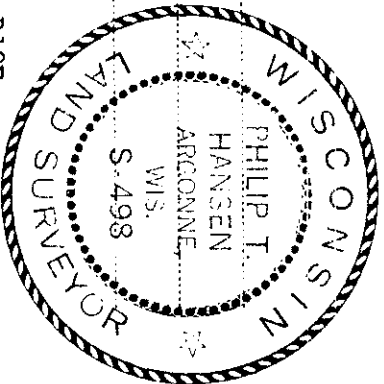

T35N R10E

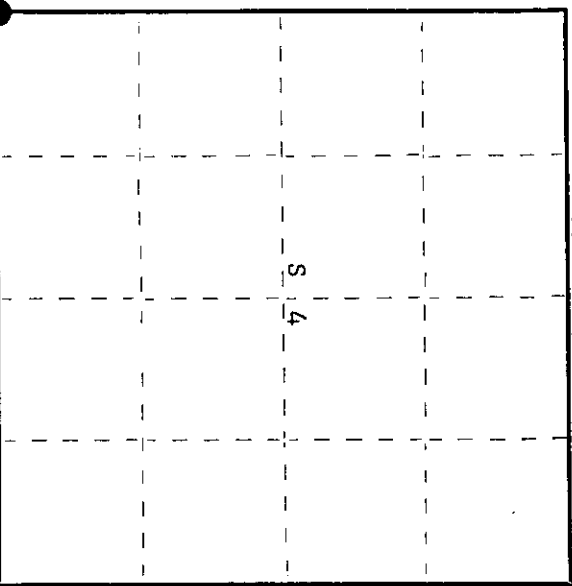

○ = Corner monument restored.

History of original corner establishment:

Original Corner established by James L. Nowlin, Deputy Surveyor, in 1865 from which Spruce 10" bears N25°W, 20 links; Tamarack 12" bears N32°E, 10 links. N. Loftus, Ripco Surveyor, re-established this corner in 1957. Set new iron pipe and marked NBTs - Cedar 7" S25°E, 17 links; Cedar 8" N84°E, 26 links.

Description of corner evidence found:

Recovered 2½" iron pipe with 4" square brass cap, projecting 2½' above ground. Monument recovered in good condition. Recovered OBTs - Cedar 7" (8") S25°E, 17 links, scribed S9 BT. Cedar 8" (9") N84°E, 26 links, scribed S4 - 35N 10E BT.

Cap stamped:

T35N R10E
5+4
8+9
RIPCO

Description of monument and accessories I established to perpetuate the original location of this corner.

Monument left in place as recovered. NBTs - Cedar 12" S71°W, 81.7 links, scribed SC BT. Maple 10" N42°W, 28 links, scribed SC BT.

Dated at Rhineland, Wis. this 30th day of June, 1977.

Signature: Phillip T. Hansen Title: Registered Land Surveyor Registration No. S-498
(County Surveyor, Registered Land Surveyor, or other duly authorized official)

Office of Register of Deeds, County of Oneida I hereby certify that the within instrument was filed in this office for record on the 20th day of July, 1977 at 1:30 o'clock P. M.

Doris Veroy Turk
(Register of Deeds)

By: Joseph M. Bremer Deputy

3510050000