

State of Wisconsin

County of Oneida } ss.



I, Philip T. Hansen, do hereby certify that on the 21st day of June, 1977, I found evidence of the Quarter corner of Section 5 & 8 Township 35 North, Range 10 East, Fourth Principal Meridian, as described hereon; and that from this evidence I established a new monument and accessories as described hereon to perpetuate the original location of this corner.

Resident witnesses:

Glen Barker

Jim Clafflin

Herb Wagoner

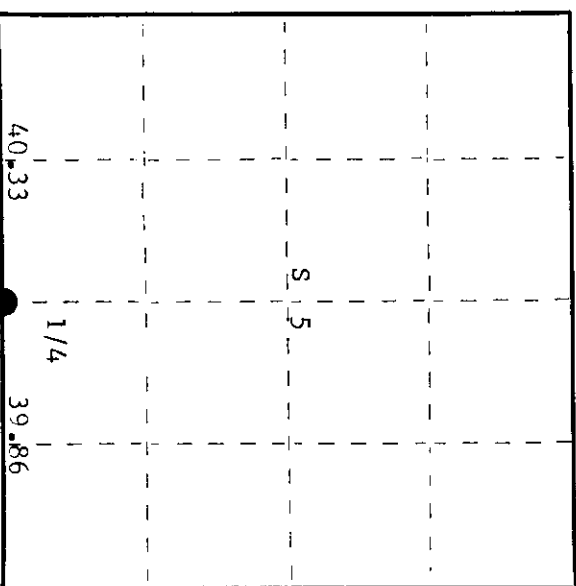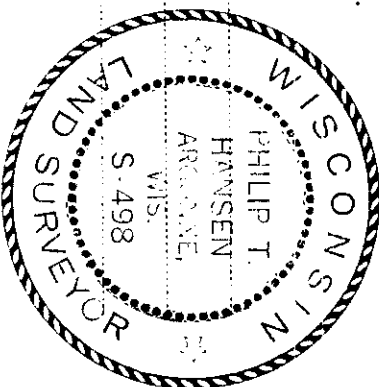

○ = Corner monument restored.

History of original corner establishment:

Original Corner established by James L. Nowlin, Deputy Surveyor, in 1865 from which Sugar 12" bears S40°W, 20 links; Spruce 12" bears N37°E, 18 links.

Corner restored by N. Loftus, Ripco Surveyor. Recovered 1/4 corner reset by a Mr. White. Set new brass cap and marked NBTs - Hemlock 14" S13°W, 28 1/2 links Red Maple 10" N23°W, 35 links.

Description of corner evidence found:

Recovered 2 1/2" iron pipe with 4" square brass cap, stamped: Monument recovered in excellent condition. Also recovered an old squared cedar post laying beside it. Monument projects 18" above ground. Recovered CBTs - Hemlock 14" S13°W, 28.5 links, scribing partly visible. Recovered 10" (12") N23°W, 35 links, scribed T35N R10E S5 BT-1/4

T35N R10E S 5 1/4

Description of monument and accessories I established to perpetuate the original location of this corner. Monument was left as recovered. Marked NBT - Hemlock 10" N80°W, 42.6 links, scribed 1/4 BT.

Dated at Rhinelander, Wis. this 30th day of June, 1977

Signature: Philip T. Hansen, Title: Registered Land Surveyor, Registration No. S-498 (County Surveyor, Registered Land Surveyor, or other duly authorized official)

Office of Register of Deeds, County of Oneida. I hereby certify that the within instrument was filed in this office for record on the 8th day of July, 1977 at 1:20 o'clock P.M.


By: Joseph M. Bonner, Deputy