

CERTIFIED LAND CORNER RESTORATION

Index No. **C-9**



State of Wisconsin

County of Oneida } ss.

I Phillip T. Hansen, do hereby certify that on the 20th day of June, 1977, I found evidence of the Quarter corner of Section 4 & 5 Township 35, North, Range 10 East, Fourth Principal Meridian, as described hereon; and that from this evidence I established a new monument and accessories as described hereon to perpetuate the original location of this corner.

Resident witnesses:

- Glen Barker
- Jim Claflin
- Herb Wagoner

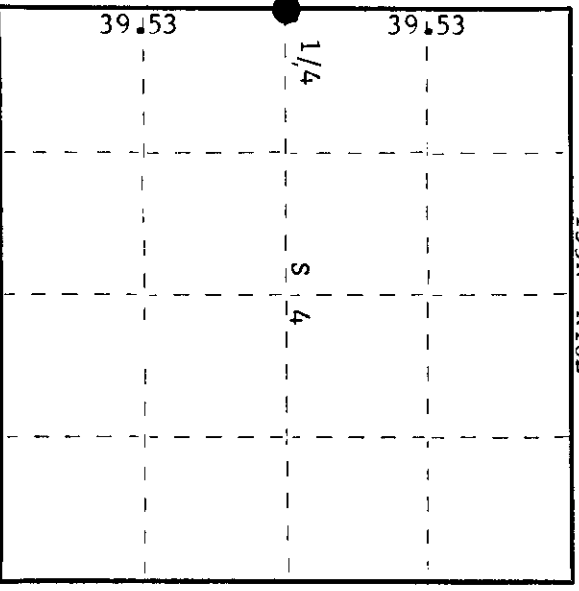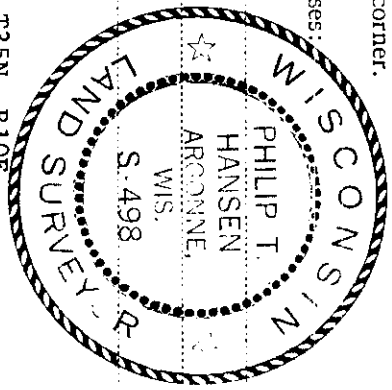

○ = Corner monument restored.

History of original corner establishment:

Original Corner established by James L. Nowlin, Deputy Surveyor, in 1865, from which Aspen 20" bears S72°W, 10 links and Birch 10" bears N73°E, 15 links.
 N. Loftus, Ripco Surveyor, searched for but unable to locate any corner in 1957.
 Ran random line south 1° 06' 30" East. Closed out 2.43½ chains west of Section Corner, Iron pipe with brass cap, 1/4 corner set at 39.53 chains south.

Description of corner evidence found:

- Recovered 2" iron pipe with 4" brass cap stamped: Monument recovered in good condition.
- Recovered OBTS - Hemlock 14" S42°W, 50 links, scribing visible. Maple 10" N20°E, 29.5 links, scribing visible.
- Monument projects 18" above ground.

1/4 S
 S5 S4
 +
 RIPCO

Description of monument and accessories I established to perpetuate the original location of this corner.
 Monument left as recovered.
 Marked NBT - Maple 10" N56°W, 16.2 links, scribed 1/4 BT.

Dated at Rhineland, Wis., this 29th day of June, 1977.

Signature Phillip T. Hansen Title Registered Land Surveyor Registration No. S-498
 (County Surveyor, Registered Land Surveyor, or other duly authorized official)

Office of Registrar of Deeds, County of Oneida
 Instrument was filed in this office for record on the 8th day of July, 1977
 at 1:32 o'clock P. M. I hereby certify that the within

Terri Savage Kuehl
 (Registrar of Deeds)

By Joseph M. Berman Deputy