

CERTIFIED LAND CORNER RESTORATION

Index No. **C-7**

State of Wisconsin

County of Oneida } ss.



I Phillip T. Hansen, do hereby certify that on the 11th day of October, 1978, I found evidence of the C 1/4 corner of Section 5 Township 35, North, Range 10 East, Fourth Principal Meridian,

as described hereon; and that from this evidence I established a new monument and accessories as described hereon to perpetuate the original location of this corner.

Resident witnesses:

Jim Claflin

Herb Wagoner

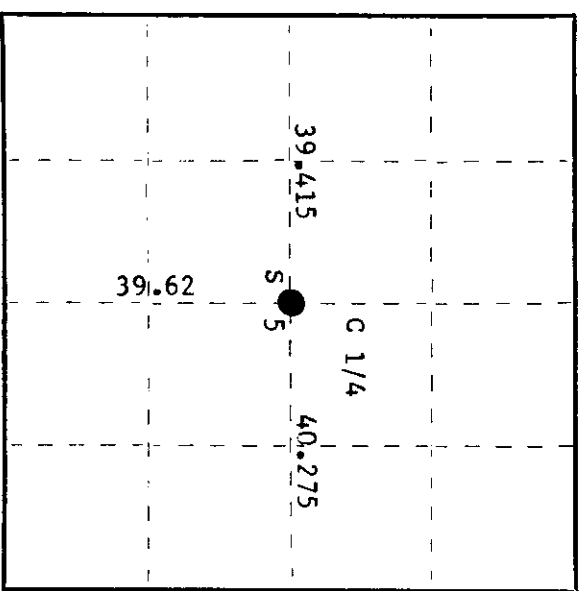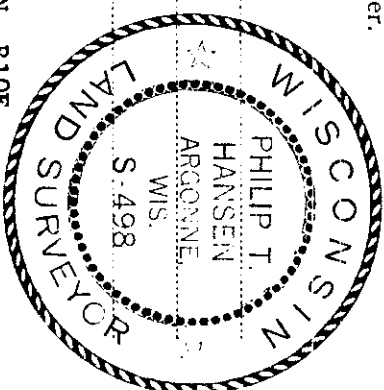

○ = Corner monument restored.

History of original corner establishment:

Corner established by N. Loftus, Ripco Surveyor, in 1956. From previously established 1/4 corners, established the C 1/4 corner. Set corner at 39.62 chains north of S 1/4, 40.475 chains south of N 1/4.

Marked NBT's -
Black Spruce 6" N45°W 53.0 links
Maple 6" S25°E, 27.0 links

Description of corner evidence found:

Recovered Ripco's 2 1/2" iron pipe with 6" square brass cap projecting 1' above ground in good condition, cap stamped:
Recovered OBT's - Black Spruce 6" N45°W, 53.0 links (53.8 links),
scribed C 1/4 S5.
Maple 6" S25°E, 27.0 links (28.5 links),
scribed C 1/4 S5 BT. C 1/4 S5 RIFCO

Description of monument and accessories I established to perpetuate the original location of this corner.
Monument recovered in good condition. Left in place as recovered.

Marked NBT's -
Black Spruce 7" S3°W 20.6 links
Black Spruce 12" S31°E 42.5 links, scribed C 1/4 BT

Dated at Rhineland, Wis., this 23rd day of October, 1978

Signature Phillip T. Hansen, Title Registered Land Surveyor Registration No. S-498
(County Surveyor, Registered Land Surveyor, or other duly authorized official)

Office of Register of Deeds, County of Oneida
Instrument was filed in this office for record on the 6th day of November, 1978
at 10:00 o'clock A. M.

Doris George Kuehn
(Register of Deeds)

By: _____ Deputy

3510052020