


CERTIFIED LAND CORNER RESTORATION

Index No. **B-7**

State of Wisconsin }  
 County of Oneida } ss.

I Phillip T. Hansen, do hereby certify that on the 11th day of October, 1978, I found evidence of the NC 1/16 corner of Section 5 Township 35, North, Range 10 East, Fourth Principal Meridian, as described hereon; and that from this evidence I established a new monument and accessories as described hereon to perpetuate the original location of this corner.


Resident witnesses:  
Jim Claflin  
Herb Wagoner

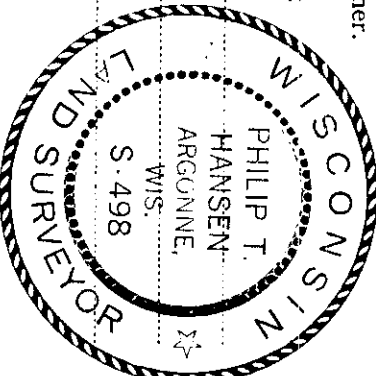

History of original corner establishment:  
 Corner established by N. Loftus, Ripco surveyor, in 1956. Established C 1/4 at 40.475 chains south of N 1/4 corner S 3° 25' E from random line between previously established 1/4 corners. Set NC 1/16 at 20.00 chains north of C 1/4.  
 Marked NBT's - Red Maple 10" S51°E, 27-3/4 links  
 Black Spruce 8" N58°W, 35-1/4 links

Description of corner evidence found:  
 Recovered Ripco's 1" iron pipe with 2" square brass cap, projecting 2 1/2' above ground. Cap stamped:  
 Recovered Maple 10" (14") S21°E, 27.75 links, scribing legible  
 B.Spruce 8" (12") N58°W, 35.25 links (N53°W), scribing grown over  
 N 1/16 | S5  
 C  
 RIPCO

Description of monument and accessories I established to perpetuate the original location of this corner.  
 As monument was recovered in good condition, it was left in place as recovered.  
 No additional accessories established

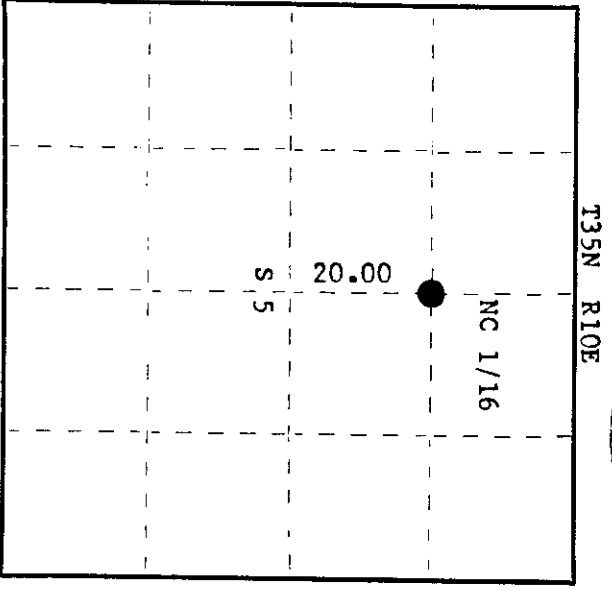

○ = Corner monument restored.

Dated at Rhineland, Wis., this 23rd day of October, 1978

Signature Phillip T. Hansen Title Registered Land Surveyor Registration No. S-498  
 (County Surveyor, Registered Land Surveyor, or other duly authorized official)

Office of Register of Deeds, County of Oneida  
 Instrument was filed in this office for record on the 10th day of November, 1978  
 at 10:00 o'clock A.M.

Lorrie Verage Kuehn  
 (Register of Deeds)

By: \_\_\_\_\_ Deputy

3510053020