


State of Wisconsin

County of Oneida } ss.


I Philip T. Hansen, do hereby certify that on the 20th day of June 1977, I found evidence of the Section corner of Sec. 5, 6, 7 & 8 Township 35 North, Range 10 East, Fourth Principal Meridian, as described hereon; and that from this evidence I established a new monument and accessories as described hereon to perpetuate the original location of this corner.

Resident witnesses:

- Glen Barker
- Jim Claflin
- Herb Wagoner

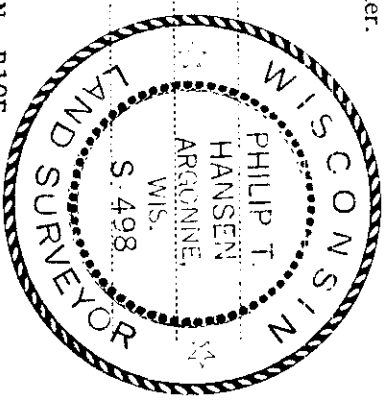

T35N R10E

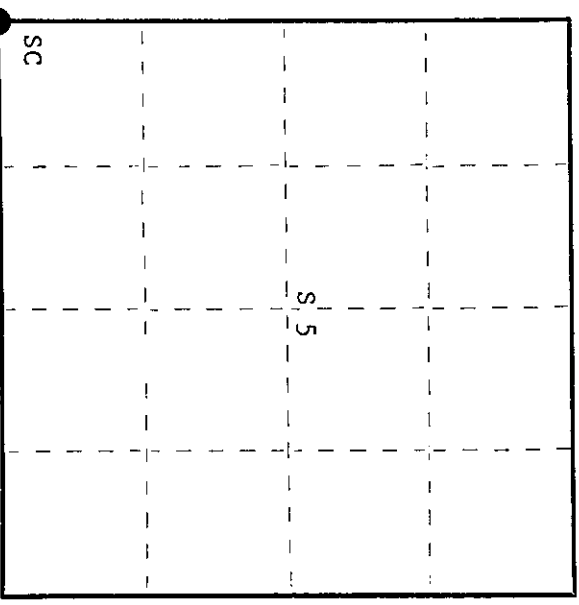

○ = Corner monument restored.

History of original corner establishment:

Original Corner established by James L. Nowlin, Deputy Surveyor, in 1865 from which Tamarack 14" bears N43°E, 15 links; Tamarack 12" bears N45°W, 23 links. This corner restored by B.F. Dorr, County Surveyor. N. Loftus, Ripco Surveyor, recovered Dorr's point in 1957. Ran random line from 1/4 corner between Sec. 7 & 8, north 19.56 chains, recovered Lawrence's N 1/16 corner. Continued north and at 19.56, recovered point of Dorr's post. Corrected bearing N3°12'W. Marked NBTs - Black Spruce 3" West 42 links Red Maple 6" N2°W, 42½ links Set iron pipe with brass cap. Description of corner evidence found:
 Recovered 2½" iron pipe with 4" square brass cap in perfect condition.
 Corner sets in tag alder swamp. Cap stamped:
 Recovered OBT - Black Spruce 3" (4") West, 42 links, scribing grown over. T35N R10E
 Maple, Red, 6" (7") N2°W 42.5 lks (43.0 lks), scribing 61.5
 grown over. RIPCO 71.8

Description of monument and accessories I established to perpetuate the original location of this corner.
 No additional accessories established.
 No suitable trees near for BTs.

Dated at Rhineland, Wis., this 30th day of June 1977.

Signature *Philip T. Hansen* Title Registered Land Surveyor Registration No. S-498
 (County Surveyor, Registered Land Surveyor, or other duly authorized official)

Office of Register of Deeds, County of Oneida
 at 1:30 o'clock P.M. I hereby certify that the within instrument was filed in this office for record on the 22 day of July 1977

Tonia Terzaghi Kuehl
 (Register of Deeds)

By *Joseph M. Bostman* Deputy