

CERTIFIED LAND CORNER RESTORATION

Index No. E-3

State of Wisconsin

County of Oneida } ss.



I, Prattis T. Hansen, do hereby certify that on the 29th day of March, 1976, I found evidence of the quarter corner of Section 6 and 7 Township 25, North, Range 10 East, Fourth Principal Meridian, as described hereon; and that from this evidence I established a new monument and accessories as described hereon to perpetuate the original location of this corner.

Resident witnesses:

Glen Parison

Jim St. Martin

Terp. Wagner

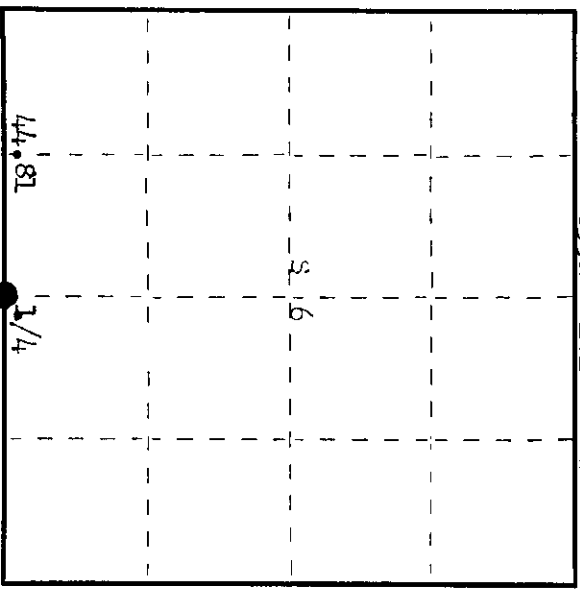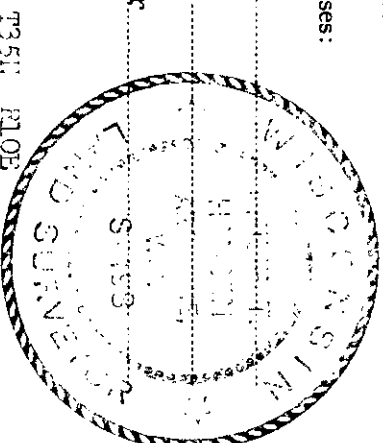

○ = Corner monument restored.

History of original corner establishment: Original corner established by James L. Nowlin, Deputy Surveyor, in 1865. Set 1/4 corner at 42.00 chains east (var. 60201) from which Sugar 8th bears N31^oW 30 lks and Fir 6th bears S65^oE 23 lks. Line between Section 6 and 7, surveyed by D.H. Vaughan, County Surveyor, in 1890. Corner recovered by H.C. Lawrence, Registered Land Surveyor, in 1949. Set a new cedar post and marked NBT - Cedar 12th S57^oE 50 lks, TT 12 L, traverse station, 10th s, concrete post with brass cap, projecting 12th bears S80^oW 19.5 lks. Corner recovered by Ripco Surveyor, Drives, in 1962. Set new cedar post in place of Lawrence's.

Description of corner evidence found: recovered Ripco's 6th cedar post, squared and scribed 1/4 S6 11^oW, 1/4 W 8thW, in poor condition. Also a 2nd iron pipe beside it. Lawrence's 6th post lying beside it. Recovered Lawrence's OBTS - Cedar 12th (144) S57^oE 50 lks, scribed 1/4 W 27, NBT. W... 12 L traverse station S80^oW 19.5 lks. Corner sets 15 lks south of Barnes fire line and 1st 2nd east of old 17th NW which is in danger of being destroyed.

Description of monument and accessories I established to perpetuate the original location of this corner.

Left Ripco's post standing, placed a 1st iron pipe inside the 2nd pipe and drove them below ground level for true corner. Set a 2nd iron pipe with brass cap for a witness corner, 1 of six north of corner. Pipe projects 18th above ground. Pipe cap stamped. 17th - Sugar Maple 12th 163^o, 176.8 lks, scribed 1/4 DT. All BNS are in reference to true corner. Post, 1st monument 3 BNS painted blue.

498
T35N R10E
1/4 S 1/4
1 ch
CPI-1976

Dated at Oneida, Wis., this 18th day of March, 1976.

Signature Prattis T. Hansen Title Registered Land Surveyor Registration No. 27428
(County Surveyor, Registered Land Surveyor, or other duly authorized official)

Office of Register of Deeds, County of Oneida 1/4 day of March, 1976. I hereby certify that the within instrument was filed in this office for record on the 20th day of March, 1976.

Signature James A. Richards
(Register of Deeds)

By James A. Richards Deputy

3510060020