

CERTIFIED LAND CORNER RESTORATION

Index No. D-4

State of Wisconsin } ss.
 County of Oneida }


History of original corner establishment:
 Corner established by Drivas and crew, Ripco surveyors, in 1962. From previously established C-S 1/16 ran S 88° 17' 55" east 40.57 chains to close out 2.2 links north of S 1/16 east line. Set SE 1/16 at 20.285 chains. Marked NBT - Black Spruce 8" S69°W 1.075 chains.

I, Phillip T. Hansen, do hereby certify that on the 20th day of December, 1977, I found evidence of the SE 1/16 corner of Section 6, Township 35 North, Range 10 East, Fourth Principal Meridian, as described hereon; and that from this evidence I established a new monument and accessories as described hereon to perpetuate the original location of this corner.


Description of corner evidence found:
 Recovered 3/4" iron pipe with alloy cap, stamped: S 6
 Monument projects 16" above ground. SE 1/16
 Monument recovered in good condition. RIPCO
 Recovered OBT - Black Spruce 8" S89°W 1.075 chains, not scribed.

Resident witnesses:

Glen Barker
 Jim Clafin
 Herb Wagoner

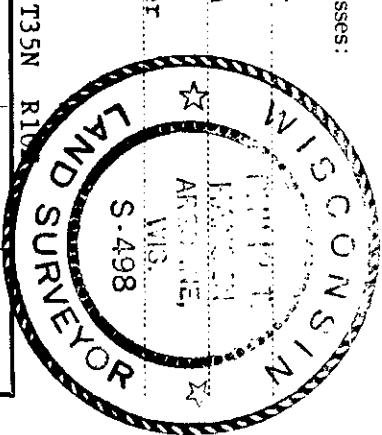

Description of monument and accessories I established to perpetuate the original location of this corner.
 Monument left in place as recovered.
 Marked NBT's - Cedar 14" N45°W 113 links
 Balsam 6" N83°W 139.3 links
 both scribed 1/16 BT.
 Corner sets in alders.

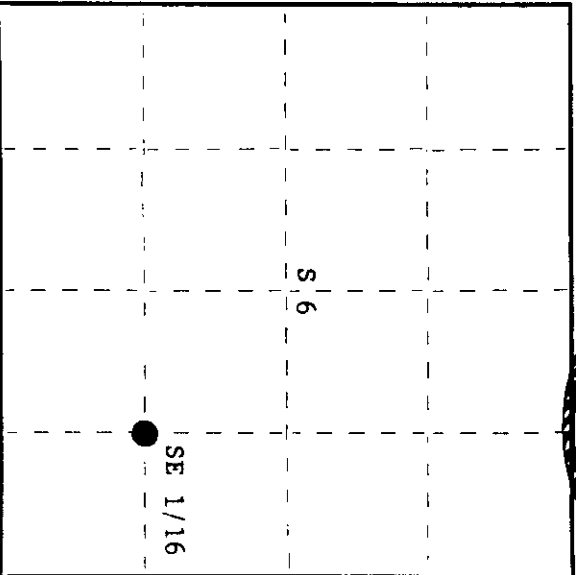

○ = Corner monument restored.

Dated at Rhinelander, Wis., this 14th day of January, 1980.

Signature: Phillip T. Hansen Title: Registered Land Surveyor Registration No. S-498
 (County Surveyor, Registered Land Surveyor, or other duly authorized official)

Office of Register of Deeds, County of Oneida, 11th day of February, 1980.
 at 2:15 o'clock P.M. I hereby certify that the within instrument was filed in this office for record on the 11th day of February, 1980.

Signature: Donna Savage Fuchs
 (Register of Deeds)

By: _____ Deputy














 







3510061010