

CERTIFIED LAND CORNER RESTORATION

Index No. D-3

State of Wisconsin

County of _____ } ss.


I, _____, do hereby certify that on the _____ day of _____, 19__ I found evidence of the _____ corner of _____ Township _____ North, Range _____ Fourth Principal Meridian, as described hereon; and that from this evidence I established a new monument and accessories as described hereon to perpetuate the original location of this corner.

Resident witnesses:

History of original corner establishment:

Description of corner evidence found:

Description of monument and accessories I established to perpetuate the original location of this corner.

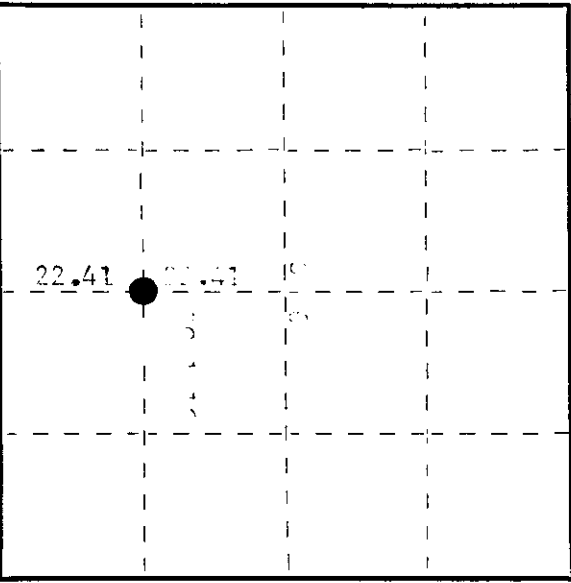

○ = Corner monument restored.

Dated at _____, Wis., this _____ day of _____, 19__

Signature _____ Title _____ Registration No. _____
(County Surveyor, Registered Land Surveyor, or other duly authorized official)

Office of Register of Deeds, County of _____
I hereby certify that the within instrument was filed in this office for record on the _____ day of _____, 19__ at _____ o'clock _____ M.

(Register of Deeds)

By _____ Deputy

3510061020