

CERTIFIED LAND CORNER RESTORATION



Index No. **C-5**

State of Wisconsin


I, Philip DeHaven, do hereby certify that on the 21 day of February, 1978, I found evidence of the original corner of Section 36, Township North, Range Fourth Principal Meridian, as described hereon; and that from this evidence I established a new monument and accessories as described hereon to perpetuate the original location of this corner.

Resident witnesses:

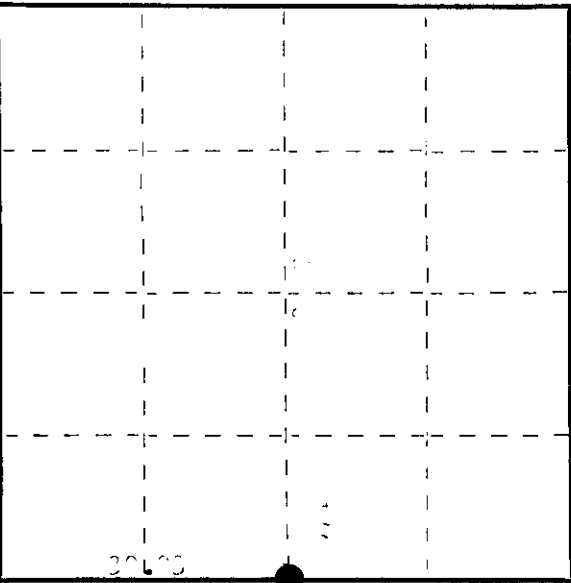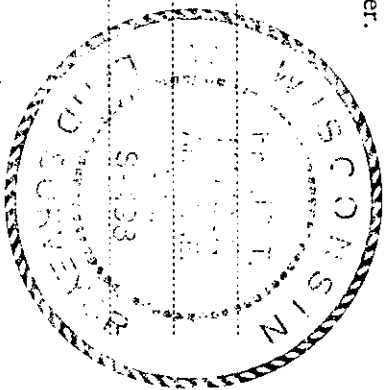

○ = Corner monument restored.

History of original corner establishment:

[Faint, mostly illegible text describing the history of the original corner establishment.]

Description of corner evidence found:

[Faint, mostly illegible text describing the corner evidence found.]

Description of monument and accessories I established to perpetuate the original location of this corner.

[Faint, mostly illegible text describing the monument and accessories.]




(Register of Deeds)

3510060000