

CERTIFIED LAND CORNER RESTORATION

Index No. C-3

State of Wisconsin }  
County of Oneida } ss.


I Philip T. Hansen, do hereby certify that on the 13th day of December, 1977, I found evidence of the C 1/4 corner of Section 6 Township 35, North, Range 10 East, Fourth Principal Meridian, as described hereon; and that from this evidence I established a new monument and accessories as described hereon to perpetuate the original location of this corner.

Resident witnesses:

Glen Barker

Jim Claflin

Herb Wagoner

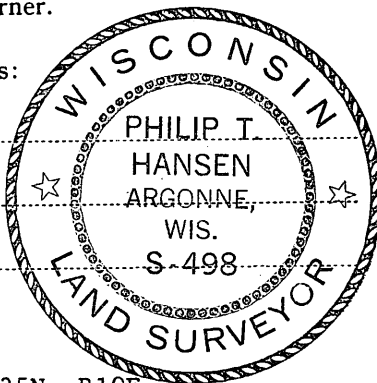

History of original corner establishment:

Corner established by Drivas and crew, Ripco surveyors, in 1962. Ran random line east from W 1/4 corner to E 1/4 corner. Corrected same. Ran random line north from south 1/4 corner 84.15 chains to close out 2.1 links east of north 1/4 corner. Established C 1/4 corner at 44.82 chains.

Marked NBT's - Yellow Birch 6" S44°E, 71 links  
White Pine 9" S79°W, 31½ links


Description of corner evidence found:

Recovered 2" aluminum pipe with aluminum cap, stamped:  
Monument recovered in good condition, projects 12" above ground.  
Recovered OBT's - Yellow Birch 6" (8") S44°E, 7.1 links (7.3 lks)  
White Pine 9" (10") S79°W, 31.5 links (30.7 lks)  
Both BT's scribed C 1/4 S6 BT.

T35N R10E  
C 1/4  
S 6  
RIPCO

Description of monument and accessories I established to perpetuate the original location of this corner.  
Marked NBT - Tamarack 7" N29°W, 13.4 links, scribed C 1/4 BT.

FORM 985 R. C. MILLER CO., MILWAUKEE

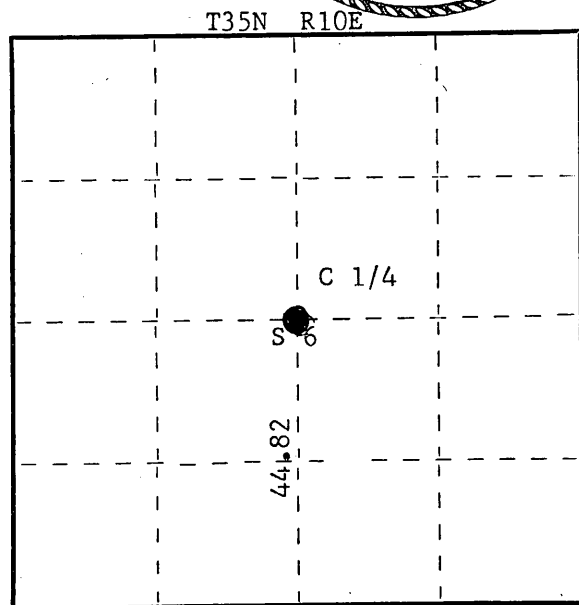

○ = Corner monument restored.

Dated at Rhineland, Wis., this 16th day of December, 1977

Signature Philip T. Hansen Title Registered Land Surveyor Registration No. S-498  
County Surveyor, Registered Land Surveyor, or other duly authorized official)

Office of Register of Deeds, County of Oneida, I hereby certify that the within instrument was filed in this office for record on the 3rd day of January, 1978 at 3:00 o'clock P M.

Doris Verage Kuehn  
(Register of Deeds)

By Joseph M. Boomer Deputy

0202900158