

CERTIFIED LAND CORNER RESTORATION



Index No. **B-5**

State of Wisconsin



Resident witnesses:

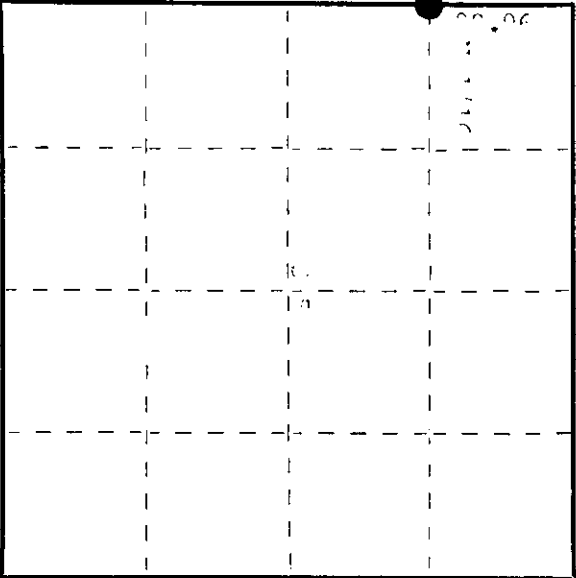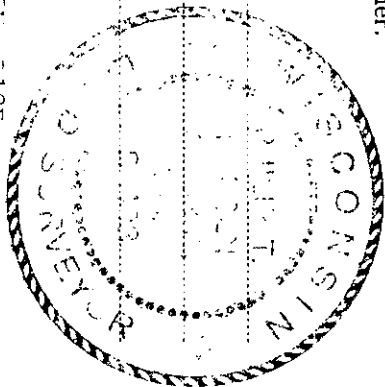

○ = Corner monument restored.

History of original corner establishment:

[Faint, illegible text describing the history of the original corner establishment.]

Description of corner evidence found:


Description of monument and accessories I established to perpetuate the original location of this corner.



(County Surveyor, Registered Land Surveyor, or other duly authorized official)

Office of Register of Deeds, County of Walworth, I hereby certify that the within instrument was filed in this office for record on the 9th day of September, 1978 at 2:05 o'clock P. M.

By Donna George Kuehn (Register of Deeds)

By _____ Deputy

3510063000