
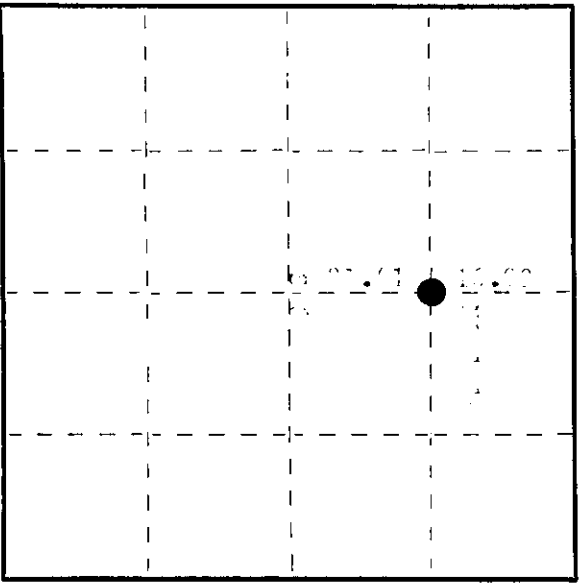


State of Wisconsin

County of _____ } ss.

I, _____, do hereby certify that on the _____ day of _____, 19____, I found evidence of the _____ corner of _____ Township _____ North, Range _____ Fourth Principal Meridian, as described hereon; and that from this evidence I established a new monument and accessories as described hereon to perpetuate the original location of this corner.

Resident witnesses:

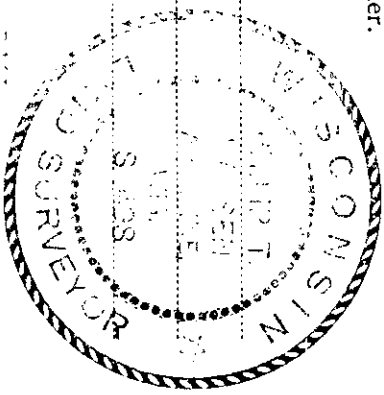

○ = Corner monument restored.

History of original corner establishment:

[Faint, illegible text describing the history of the original corner establishment.]

Description of corner evidence found:

[Faint, illegible text describing the corner evidence found.]

Description of monument and accessories I established to perpetuate the original location of this corner.

[Faint, illegible text describing the monument and accessories.]

Dated at _____, Wis., this _____ day of _____, 19____

Signature *[Handwritten Signature]* Title _____ Registration No. _____
County Surveyor, Registered Land Surveyor, or other duly authorized official

Office of Register of Deeds, County of _____
Instrument was filed in this office for record on the _____ day of _____, 19____
at _____ o'clock _____ M.

[Handwritten Signature]
(Register of Deeds)

By: _____ Deputy