
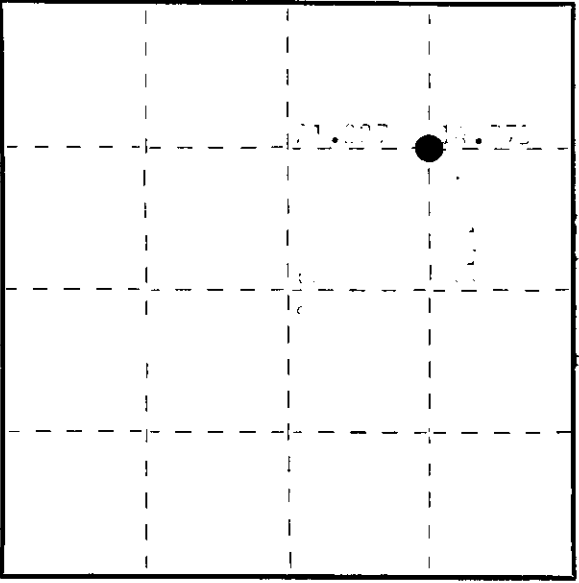


State of Wisconsin


I, Richard J. Starnes, do hereby certify that on the 10th day of September, 1978, I found evidence of the old corner of Section 35, Township North, Range Fourth Principal Meridian, as described hereon; and that from this evidence I established a new monument and accessories as described hereon to perpetuate the original location of this corner.

Resident witnesses:

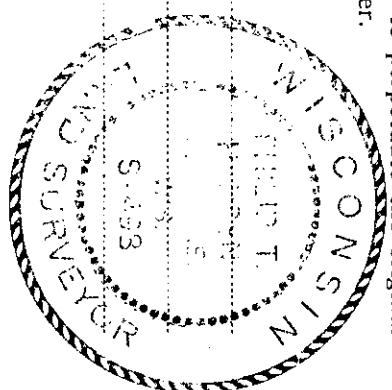

○ = Corner monument restored.

History of original corner establishment:



Description of corner evidence found:


Description of monument and accessories I established to perpetuate the original location of this corner.



(County Surveyor, Registered Land Surveyor, or other duly authorized official)



