

CERTIFIED LAND CORNER RESTORATION


Index No. H-5

History of original corner establishment: Corner originally set by S. Dorr. Corner searched for by H.C. Lawrence, but he was unable to locate it. Corner restored by Ripco surveyor (Drivas). Set pin in center of 3TH "G" and marked BT - Tamarack 9" N46°W 73 lks.


State of Wisconsin } ss.
 County of Oneida }
 I, Phillip T. Hansen, do hereby
 certify that on the 31st day
 of March, 1976, I found
 evidence of the S 1/16
 corner of Section 7 and 8
Township 35, North, Range
10 East, Fourth Principal Meridian,
 as described hereon; and that from this evidence
 I established a new monument and accessories
 as described hereon to perpetuate the original
 location of this corner.

Resident witnesses:

Glen Barker
Jim Clafin
Herb Wagoner

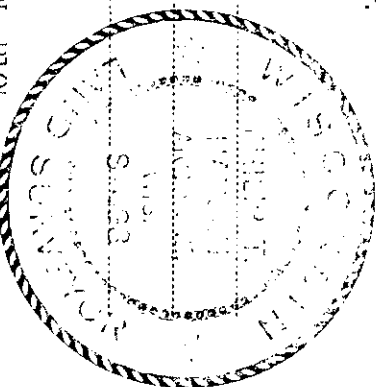

T35N R10E

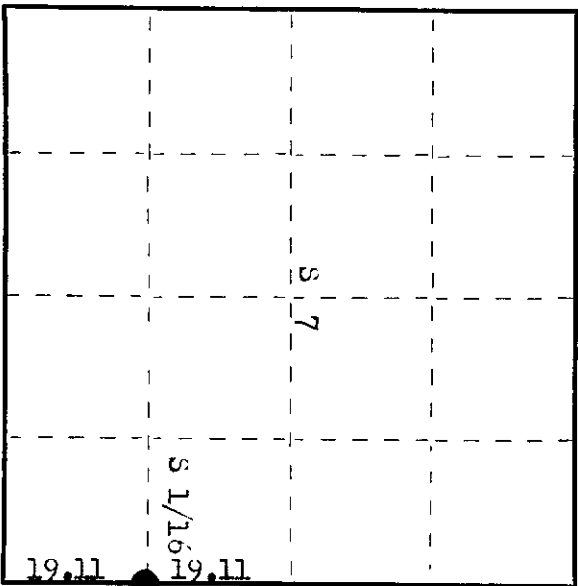

○ = Corner monument restored.

Description of corner evidence found: Unable to recover pin in highway. Apparently it had been destroyed during road building. Recovered OBT - Tamarack 9" (10") N46°W 73 lks, scribed S 1/16 BT. Corner location set from OBT.

Description of monument and accessories I established to perpetuate the original location of this corner.

Set a 1 1/2" iron pipe with 2" brass cap for witness monument, 80 lks south of true corner, marked with railroad spike buried below surface of the highway. witness monument projects 18 inches above ground. Cap stamped.
 No suitable trees near for BT.
 witness monument - 1 1/2" x 5 ft. iron pipe, 18" above ground N42°E 85 lks. 3498
 Corner sets in the center of north lane 3TH "G". T35N R10E
 witness corner and witness monument and OBT painted blue. 31/16 718 "C.C."
 N 80 lks
 1976

Dated at Rhineland Wis. this 19th day of May, 1976

Signature Phillip T. Hansen Title Registered Land Surveyor Registration No. 3-498
 (County Surveyor, Registered Land Surveyor, or other duly authorized official)

Office of Register of Deeds, County of Oneida. I hereby certify that the within
 instrument was filed in this office for record on the 1st day of March, 1976
 at 10:30 o'clock A.M.

James H. ...
 (Register of Deeds)

By: James H. ... Deputy

3510071000