

CERTIFIED LAND CORNER RESTORATION

Index No. G-3



State of Wisconsin

County of Oneida } ss.

I, Phillip T. Hansen, do hereby certify that on the 2nd day of April, 1976, I found evidence of the S 1/4 corner of Section 7 Township 35, North, Range 10 East, Fourth Principal Meridian, as described hereon; and that from this evidence I established a new monument and accessories as described hereon to perpetuate the original location of this corner.

Resident witnesses:

- Glenn Barker
- Jim Clafflin
- Herb Jagoner

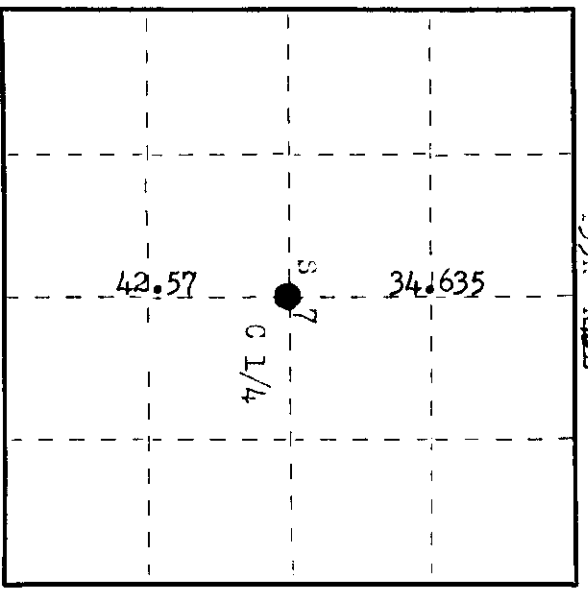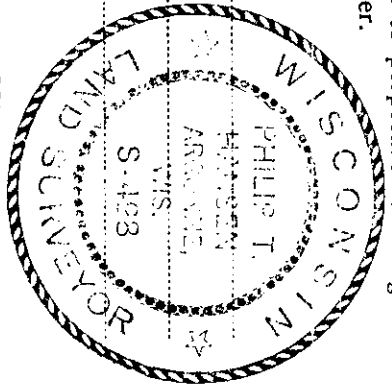

○ = Corner monument restored.

History of original corner establishment: Corner established by H.O. Lawrence, registered Land Surveyor, in 1949. Did not make any bearing trees. Corner established by Ripco Surveyor (Privas) in 1962. Unable to recover Lawrence's corner. Ran random line from S 1/4 corner to N 1/4 corner and set C 1/4 by proportion against Lawrence's corner and BTs. Set C 1/4 corner at 42.57 chains north of S 1/4 corner. Set pin in road and marked NBTs - Ash 4" N59° 49' 2 lks, Maple 5" N65° 61 lks.

Description of corner evidence found: Unable to recover pin in road, having been destroyed by road construction.

Recovered OBTs - Ash 4" N89° 49.5 lks, now a 4' cut off stump, scribed C 1/4 BT.  
Maple 5" (6") N65° 61 lks. scribed S7 C 1/4 BT.

Description of monument and accessories I established to perpetuate the original location of this corner.

Re-established point for corner by intersection of bearings and distances from BTs.  
Set RR spike below surface of blacktop.  
Set 2 1/2" iron pipe with brass cap for witness monument 95 lks west of corner.  
Pipe projects 18" above ground, cap stamped.  
NBTs - Twin sugar 8" & 6" S30° 114.5 lks scribed 1/4 BT.  
Pipe and BTs painted blue.

T35N R10E  
S 7  
C 1/4  
42.57 lks.  
1976

Dated at Mineral Point, Wis. this 21st day of MAY, 1976.

Signature Phillip T. Hansen Title Registered Land Surveyor Registration No. S-498  
(County Surveyor, Registered Land Surveyor, or other duly authorized official)

Office of Register of Deeds, County of Oneida 16th day of June 1976  
I hereby certify that the within instrument was filed in this office for record on the 16th day of June, 1976 at 2:00 o'clock P. M.

David Thompson  
(Register of Deeds)

By David Thompson Deputy

3510072020