

CERTIFIED LAND CORNER RESTORATION

Index No. E-5

State of Wisconsin

County of Oneida } ss.

I Phillip T. Hansen, do hereby certify that on the 12th day of October, 1978, I found evidence of the N 1/16 corner of Section 7 & 8



Township 35, North, Range 10 East, Fourth Principal Meridian,

as described hereon; and that from this evidence I established a new monument and accessories as described hereon to perpetuate the original location of this corner.

Resident witnesses:

Jim Claflin

Herb Wagoner

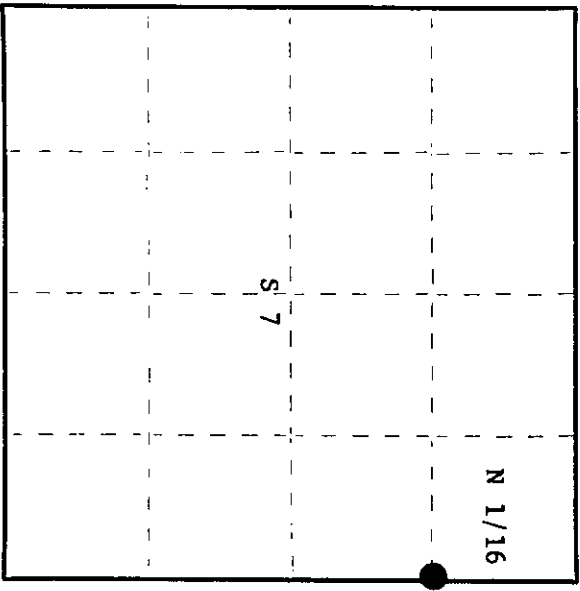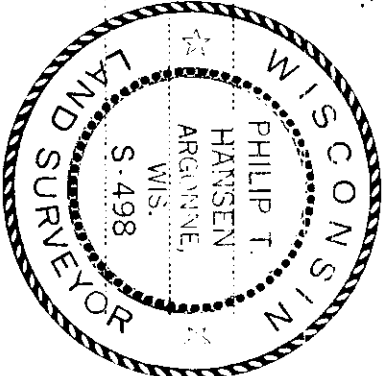

○ = Corner monument restored.

History of original corner establishment:

H.C. Lawrence, Registered Land Surveyor, recovered an old white birch BT 12" S83°E 19 links believed to be Vaughan's BT. Set new cedar post and marked NBT, Sugar 12" S38°W, 54 links.
N. Loftus, Ripco surveyor, tied to this corner in 1962. Set a new iron pipe.

Description of corner evidence found:

Recovered H.C. Lawrence's 5" square cedar post in poor condition, stamped N 1/16 S7, N 1/16 S8. Also recovered Ripco's 1" iron pipe with 3" square brass cap in good condition beside wood post.
Recovered H.C. Lawrence's BT - Sugar 12" S38°W 54 links, now a rotted stump.
No trace left of white birch S 83° E, 19 links.
Monument projects 2 1/2 ft. above ground. Cap stamped:



Description of monument and accessories I established to perpetuate the original location of this corner.

Monument left in place as recovered.
Marked NBT's - white spruce 8" N85°W, 37.4 links
white birch 8" S12°E, 8.1 links
both scribed 1/16 BT

Dated at Rhineland, Wis., this 23rd day of October, 1978

Signature Phillip T. Hansen Title Registered Land Surveyor Registration No. S-498
(County Surveyor, Registered Land Surveyor, or other duly authorized official)

Office of Register of Deeds, County of Oneida. I hereby certify that the within instrument was filed in this office for record on the 6th day of November, 1978 at 10:00 o'clock a. M.

Louise Berge Fuchler
(Register of Deeds)

By: _____ Deputy

3510073000