

CERTIFIED LAND CORNER RESTORATION

Index No. H-7

State of Wisconsin }  
 County of Oneida } ss.



I Philip T. Hansen, do hereby certify that on the 31st day of March, 1976, I found evidence of the SC 1/16 corner of Section 8 Township 35, North, Range 10 East, Fourth Principal Meridian, as described hereon; and that from this evidence I established a new monument and accessories as described hereon to perpetuate the original location of this corner.

Resident witnesses:

Glen Barker

Jim Claflin

Herb Wagoner

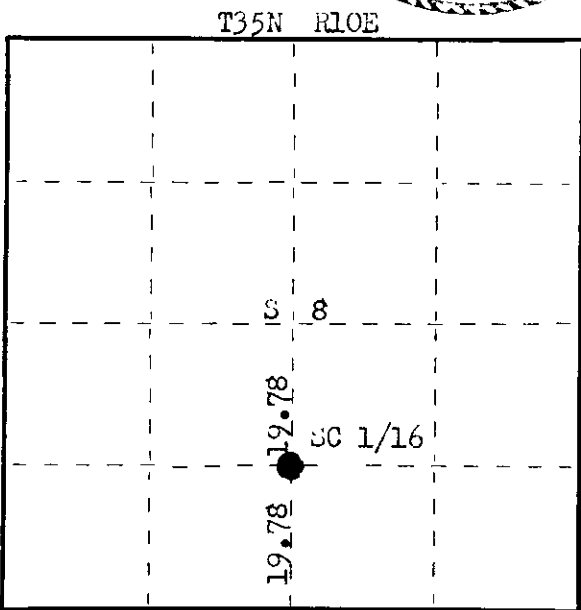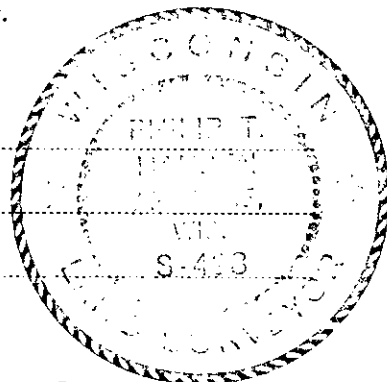

○ = Corner monument restored.

History of original corner establishment: Corner established by Ripco surveyors (Drivas) in 1962. Set 1" aluminum pipe with brass cap by proportional measurement. Also recovered H.C. Lawrence's post which he had set from an assumed corner in CTH "G". Ripco had found Lawrence's post 20.2 lks too far west. Marked NBTs - Maple 9" S73°E 1.105 chains, Maple 4" N40°E 86 lks. Lawrence's post west 20.2 lks.

Description of corner evidence found: Recovered Ripco's 1" aluminum pipe with brass cap. Checking ties to this pipe found it had been moved. Recovered 9" maple S73°E 1.105 chs. Checks were made to Lawrence's post from his BTs, which was found to be OK. Established correct location of corner from ties to 9" maple and Lawrence's post. No cross bar on Ripco's pipe so it could be moved. Cap had no stamp marks.

Description of monument and accessories I established to perpetuate the original location of this corner.

Set new 1" iron pipe with 2" brass cap, stamped.  
 Pipe projects 18" above ground.  
 NBTs - Maple 6" N28°E 127.7 lks, scribed 1/16 BT.  
           Aspen 11" North 38.7 lks.  
           W. Birch 8" S57°E 33 lks.  
 Pipe and BTs painted blue.  
 Removed Lawrence's post and placed it beside new monument.

S498  
 T35N R10E  
 SC 1/16 S 8  
 CPI-1976

Dated at Rainelander, Wis., this 19th day of May, 1976.

Signature Philip T. Hansen Title Registered Land Surveyor Registration No. 2-498  
 (County Surveyor, Registered Land Surveyor, or other duly authorized official)

Office of Register of Deeds, County of Oneida, I hereby certify that the within instrument was filed in this office for record on the 10th day of June, 1976 at 2:30 o'clock P. M.

James George Kuehn  
 (Register of Deeds)

By \_\_\_\_\_ Deputy

FORM 985 Wisconsin Planning Agency

3510081020