

CERTIFIED LAND CORNER RESTORATION

Index No. G-6


State of Wisconsin }
County of Oneida } ss.

I, Philip T. Hansen, do hereby certify that on the 12th day of October, 1978, I found evidence of the WC 1/16 corner of Section 8 Township 35, North, Range 10 East, Fourth Principal Meridian, as described hereon; and that from this evidence I established a new monument and accessories as described hereon to perpetuate the original location of this corner.


Resident witnesses:

Jim Claflin

Herb Wagoner

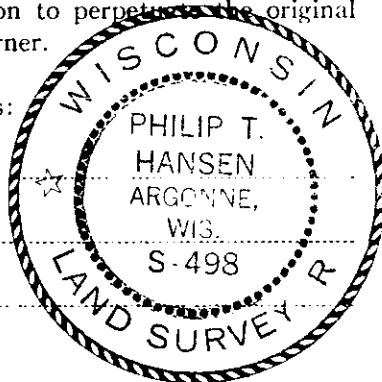

FORM 985 H. C. M. LER CO. MILWAUKEE

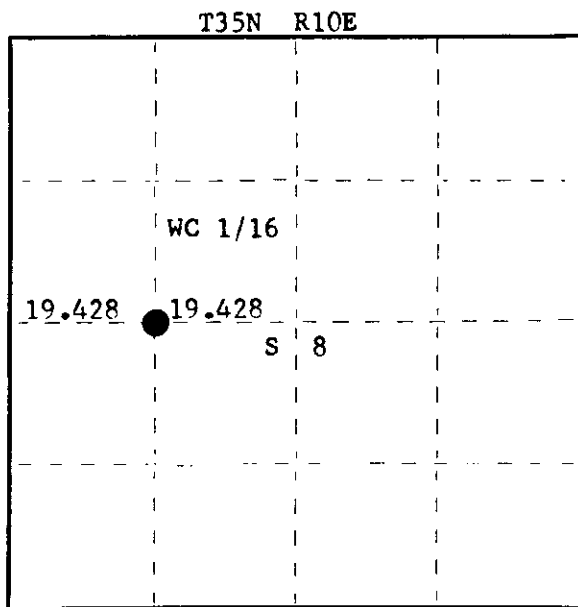

○ = Corner monument restored.

History of original corner establishment:

Corner established by N. Loftus, Ripco surveyor, in 1962. Ran random line east from W 1/4 corner bearing N 89° 53' 08" E to close out 1.103 chains south at 78.52 chains. Has note that old corners on E-W 1/4 line were off. Corrected bearing of total line is N 89° 04' 51" E, old C 1/4 at 38.859 chains. Set CW 1/16 corner at 19.428 chains intermediate.

Marked NBT's -

Maple 8" S68°E 6 links

Maple 5" N42°E 4 links

Description of corner evidence found:

Recovered Ripco's 3/4" iron pipe with 2" diameter alloy cap, not stamped, in excellent condition.

Recovered OBT's - Maple 8" (12") S68°E 6.0 links, scribing partially visible.
Maple 5" N42°E 4.0 links, no trace found of this BT.

Monument projects 24" above ground.

Description of monument and accessories I established to perpetuate the original location of this corner.

Monument left in place as recovered. Stamped the cap:

Marked NBT - Sugar 8" S84°W 46.1 links, scribed 1/16 BT.

T35N R10E
WC 1/16 S+8

Dated at Rhinelander, Wis., this 23rd day of October, 1978

Signature Philip T. Hansen Title Registered Land Surveyor Registration No. S-498
(County Surveyor, Registered Land Surveyor, or other duly authorized official)

Office of Register of Deeds, County of Oneida, I hereby certify that the within instrument was filed in this office for record on the 6th day of November, 1978 at 10:00 o'clock A M.

Doris Verage Kuehn
(Register of Deeds)

By.....Deputy

3510082030