

CERTIFIED LAND CORNER RESTORATION

Index No. G-11

State of Wisconsin



County of Oneida } ss.

I, Phillip T. Hansen, do hereby certify that on the 24th day of July, 1978, I found evidence of the C 1/4 corner of Section 9 Township 35, North, Range 10 East, Fourth Principal Meridian, as described hereon; and that from this evidence I established a new monument and accessories as described hereon to perpetuate the original location of this corner.

Resident witnesses:

Jim Claffin

Herb Wagoner

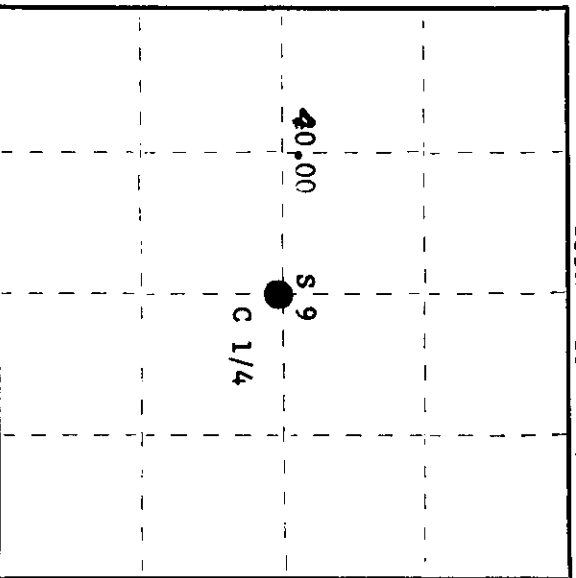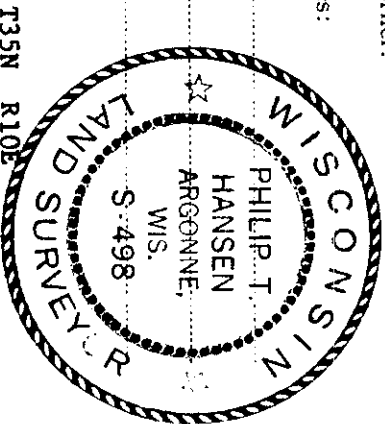

○ = Corner monument restored.

CERTIFIED LAND CORNER RESTORATION

History of original corner establishment:

Original corner established by B.F. Dorr, county surveyor, in 1899. Marked BT's - Cedar 5" N79°E, 8-3/4 links; Fir 5" N50°W, 8 1/2 links.

Corner recovered by H.C. Lawrence, Registered Land Surveyor, in 1951. Recovered Dorr's BT's - Cedar 5" N79°E, 8-3/4 links and Fir 5" N50°W, 8-1/2 links. Set new cedar posts from Dorr's calls to BT's. Marked NBT - Cedar 7" S80°E, 24 links.

Description of corner evidence found:

Recovered H.C. Lawrence's cedar post, in poor condition, partly leaning. Post scribed Ck S9.

Recovered Dorr's BT's - Cedar 5" N79°E, 8.75 links, scribing legible Balsam 5" N50°W, 8.5 links, no longer visible Cedar 7" S80°E, 24.0 links, scribed C 1/4 NBT

Description of monument and accessories I established to perpetuate the original location of this corner.

Set 2 1/2" Berntsen A-1 Federal Monument (CPI). Cap stamped: Monument projects 24" above ground.

Marked NBT's -  
Black Spruce 7" N50°E, 29.0 links T35N R10E  
White Birch 7" S28°W, 29.6 links S 9 C 1/4  
both scribed C 1/4 BT S498-1978

Dated at Rhinelander, Wis., this 26th day of July, 1978

Signature Phillip T. Hansen Title Registered Land Surveyor Registration No. S-498  
(County Surveyor, Registered Land Surveyor, or other duly authorized official)

Office of Register of Deeds, County of Oneida I hereby certify that the within instrument was filed in this office for record on the 14th day of August, 1978 at 12:45 o'clock P. M.

Doni George Tuelke  
(Register of Deeds)

By: \_\_\_\_\_ Deputy

3510092020