

CERTIFIED LAND CORNER RESTORATION



Index No. **G-10**

State of Wisconsin

County of Oneida } ss.

I Philip T. Hansen, do hereby certify that on the 24th day of July, 1978, I found evidence of the WC 1/16 corner of Section 9 Township 35, North, Range 10 East, Fourth Principal Meridian, as described hereon; and that from this evidence I established a new monument and accessories as described hereon to perpetuate the original location of this corner.

Resident witnesses:  
Jim Claffin  
Herb Wagoner

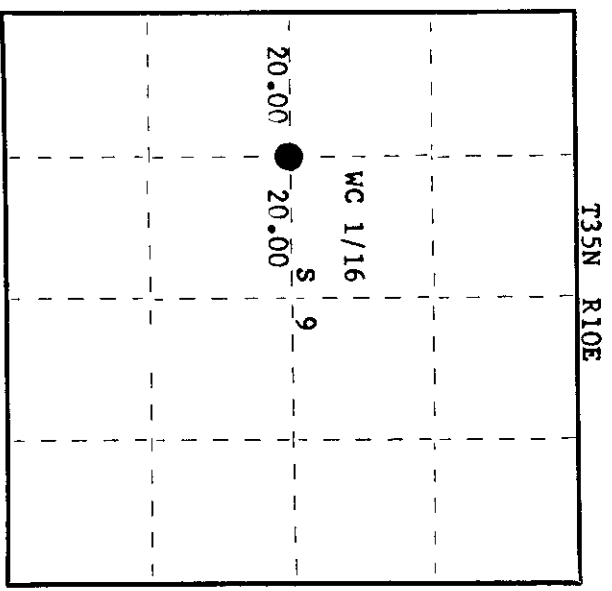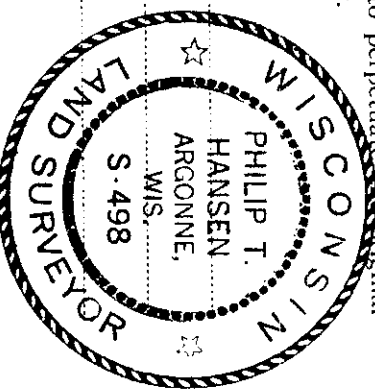

○ = Corner monument restored.

History of original corner establishment:

Corner established by H.C. Lawrence, Registered Land Surveyor, in 1951. From the 1/4 corner between section 8 & 9, which he had previously recovered from original tamarack BT, he ran east, magnetic 40.00 chains to close out 1.44 chains south of the old C 1/4 corner set by Dorr in 1899 which Lawrence recovered. Corrected bearing N 87° 56' E. Set WC 1/16 corner at 20.00 chains intermediate. Marked NBT's - white pine stump 24" N 10° W, 17 links; white pine 10" S 40° E, 40 links.

Description of corner evidence found:

Recovered H.C. Lawrence's 5" squared cedar post scribed WC 1/16 S9 - WC 1/16 S9 in good condition.  
Recovered OBT's - white pine stump N 10° W, 17.0 links, badly decayed, white birch growing out of hollow center.  
white pine 10" S 40° E, 40 links, now dead, scribed WC 1/16 NBT.

Description of monument and accessories I established to perpetuate the original location of this corner.

Replaced cedar post with 1 1/2" iron pipe with 2" brass cap, stamped:  
Monument projects 16" above ground. S498  
T35N R10E  
NBT's - Black Spruce 16" S39°E, 42.5 links WC 1/16 S 9  
Sugar 6" S22°W, 42.9 links, scribed 1/16 BT. CPI-1978

Dated at Rhinelander, Wis., this 26th day of July, 1978.

Signature Philip T. Hansen Title Registered Land Surveyor Registration No. S-498  
(County Surveyor, Registered Land Surveyor, or other duly authorized official)

Office of Register of Deeds, County of Oneida  
Instrument was filed in this office for record on the 14th day of August, 1978  
at 12:45 o'clock P. M.

Doris Verage Kuehn  
(Register Deeds)

By: \_\_\_\_\_ Deputy

3510 092030