

CERTIFIED LAND CORNER RESTORATION

Index No. J-17



State of Wisconsin

County of Oneida } ss.

I Phillip T. Hansen, do hereby certify that on the 2nd day of April, 1976, I found evidence of the Section Corner corner of Sec. 10 - 11 - 14 - 15 Township 35, North, Range 10 East, Fourth Principal Meridian, as described hereon; and that from this evidence I established a new monument and accessories as described hereon to perpetuate the original location of this corner.

Resident witnesses:

Glen Barker  
Jim Claflin  
Herb Jagoner

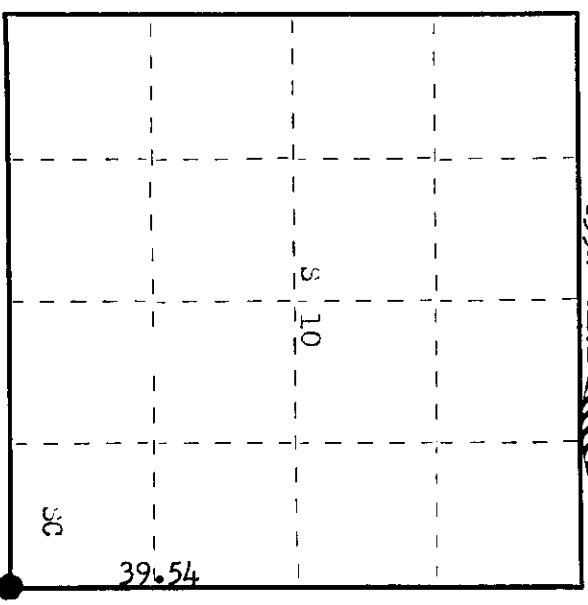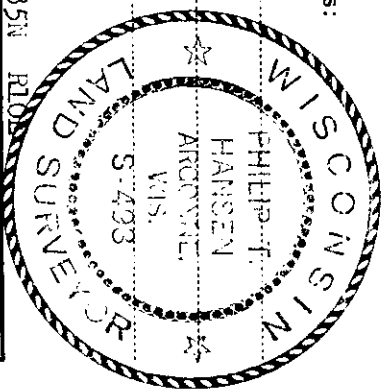

○ = Corner monument restored.

History of original corner establishment: Original corner established by James L. Nowlin, Deputy Surveyor, in 1865, from which W. Pine 8" bears N10°, 20 lks. and R. Birch 6" bears N66°E 15 lks. Corner re-established by Rowinski. Set iron pipe and established BTs. Corner recovered by Ripco surveyor (W. Loftus). Marked BTs - Oak 6" S30°E 32.1 lks. Oak 7" N61°E 33 lks.

Description of corner evidence found: Recovered 2 1/2" iron pipe with brass cap, stumped. Pipe in good condition. Projects 2' above ground. Recovered OBTS - R. Oak 9" S32°E 32.4 lks, scribing partly visible. H. Oak 8" N65°E 33.4 lks, scribing partly visible.

TW 35 North  
Section  
10 | 11  
15 | 14  
Corner  
Range 10 East

Description of monument and accessories I established to perpetuate the original location of this corner. As monument was in good shape, it was left as found. NBTS - R. Oak 9" N16°E 89.3 lks, scribed SC BT. Pipe and BTs painted blue.

Dated at Rhineland, Wis., this 21st day of May, 1976.

Signature Phillip T. Hansen Title Registered Land Surveyor Registration No. S-498  
(County Surveyor, Registered Land Surveyor, or other duly authorized official)

Office of Register of Deeds, County of Oneida, I hereby certify that the within instrument was filed in this office for record on the 12th day of April, 1976 at 2:00 o'clock P. M.

Walter A. G. ...  
(Register of Deeds)

By Phillip T. Hansen Deputy

351010000