

CERTIFIED LAND CORNER RESTORATION

Index No. J-14

State of Wisconsin



County of Oneida } ss.

I Phillip T. Hansen, do hereby certify that on the 10th day of October, 1978, I found evidence of the W 1/16 corner of Section 10 & 15 Township 35, North, Range 10 East, Fourth Principal Meridian, as described hereon; and that from this evidence I established a new monument and accessories as described hereon to perpetuate the original location of this corner.

Resident witnesses:

Jim Claffin

Herb Wagoner

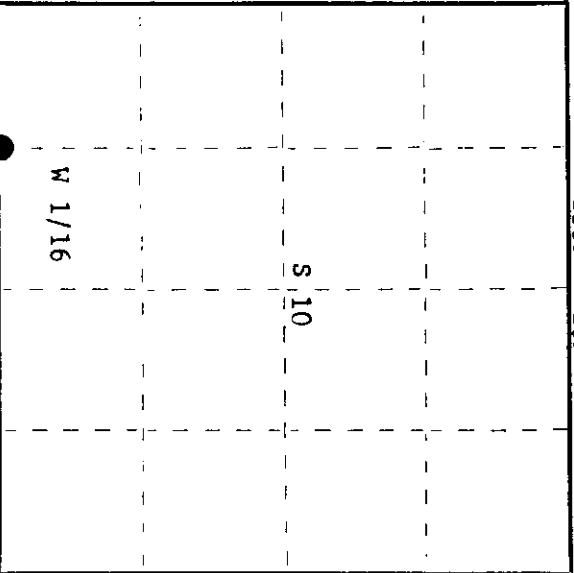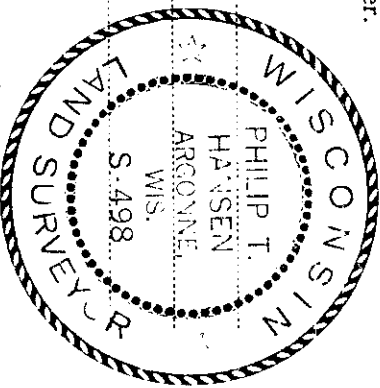

○ = Corner monument restored.

History of original corner establishment:

Corner established by D.H. Vaughan, County surveyor. Set post and marked BT's - Tamarack 9" N40°E, 10 links Hemlock stump 9" S69°W, 20 1/2 links H.C. Lawrence, Registered Land Surveyor, recovered Vaughan's old post in 1960. Also recovered his BT's. Set a new cedar post and marked NBT - W.Pine 9" N80°W, 9 links

Description of corner evidence found:

Recovered H.C. Lawrence's 5" square cedar post, scribed W 1/16 S10, W 1/16 S15. Also found the point of an old post laying beside it. Recovered tamarack 11", N40°E, 10.0 links, now a rotted stump, facing visible. White Pine 12" N80°W, 9.8 links, now a stump, scribed NBT

Description of monument and accessories I established to perpetuate the original location of this corner.

Replaced H.C. Lawrence's cedar post with 1" iron pipe with 2" brass cap projecting 24" above ground. Cap stamped:
Built a rock cairn around base of monument.
Marked NBT's - B. Spruce 6" S44°E 12.5 links T35N R10E
Tamarack 8" N8°E 25.3 links S 10
both scribed 1/16 BT. W 1/16 S 115
CPI-1978

Dated at Rhineclander, Wis., this 18th day of October, 1978

Signature: Phillip T. Hansen Title: Registered Land Surveyor Registration No. S-498
(County Surveyor, Registered Land Surveyor, or other duly authorized official)

Office of Register of Deeds, County of Oneida at 6:00 o'clock P. M. I hereby certify that the within instrument was filed in this office for record on the 6th day of November, 1978

Donna Verage Fischer
(Register of Deeds)

By: _____ Deputy

35100030