

CERTIFIED LAND CORNER RESTORATION

Index No. A-17

State of Wisconsin } ss.
County of Oneida



Philip T. Hansen, do hereby
certify that on the 7th day
of April, 1976, I found

evidence of the S 1/16
corner of Section 10 & 11
Township 35, North, Range
10 East, Fourth Principal Meridian,

as described hereon; and that from this evidence
I established a new monument and accessories
as described hereon to perpetuate the original
location of this corner.

Resident witnesses:

- Glen Barker
- Jim Claflin
- Herb Wagoner

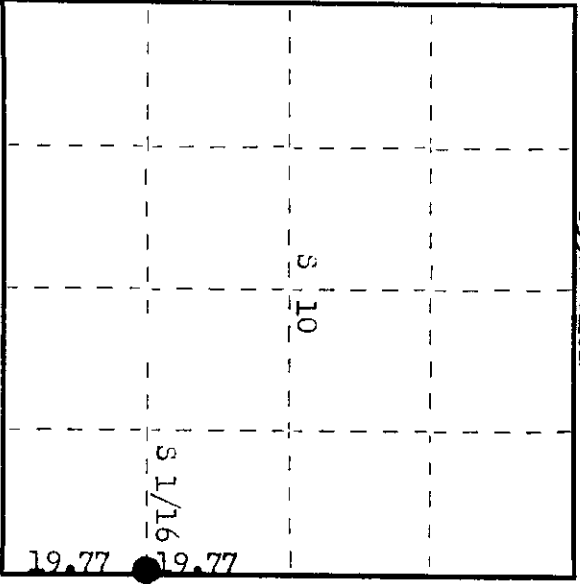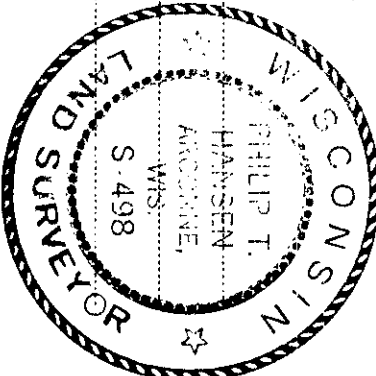

○ = Corner monument restored.

History of original corner establishment: Corner established by D.H. Vaughan, County Surveyor, in 1899, from which Y. Pine 20" bears N 79° E 69 lks and Y. Pine 18" bears N 38° .. 41 lks. H.C. Lawrence, registered land surveyor, was unable to locate corner or Vaughan's BTs during his retracement survey. Corner re-established by W. Loftus, Ripco Surveyor, and H.C. Lawrence, registered land surveyor, in 1960.

Set corner by proportion, 19.77 chains equidistant between quarter corner and Section Corner 10, 11, 14 and 15. Marked NBTs - Red Pine 8" S 54° E 1.275 chs. Pine 7" N 33° W 1.34 chains.

Description of corner evidence found: Recovered 1" iron pipe with 2" brass cap stamped, in good condition.
Recovered OBTs - R. Pine 8" (12") S 54° E (S 50° E) 1.275 chains.
Y. Pine 7" (9") N 33° W (N 29° W) 1.34 chains.
Scried S 1/16 BT.

S 1/16
S10 | S11
T35N R10E
Ripco

Description of monument and accessories I established to perpetuate the original location of this corner.
As the recovered monument was in good condition and firm in the ground, it was left in place.

Monument and BTs painted blue.

No additional accessories established.

Dated at Thiulander, Wis., this 6th day of July, 1976

Signature Philip T. Hansen Title Registered Land Surveyor Registration No. S-498
(County Surveyor, Registered Land Surveyor, or other duly authorized official)

Office of Register of Deeds, County of Oneida I hereby certify that the within
instrument was filed in this office for record on the 23rd day of July, 1976
at 100 o'clock P. M.

Robert George Keehn
(Register of Deeds)

By Philip T. Hansen Deputy

000101035