

CERTIFIED LAND CORNER RESTORATION

Index No. J-21

State of Wisconsin

County of Oneida

} ss.

I, Phillip T. Hansen, do hereby certify that on the 6th day of March, 1978, I found evidence of the Section Corner corner of 11 - 12 - 13 - 14 Township 35, North, Range 10 East, Fourth Principal Meridian,


as described hereon; and that from this evidence I established a new monument and accessories as described hereon to perpetuate the original location of this corner.

Resident witnesses:


Glen Barker

Jim Claflin

Herb Wagoner

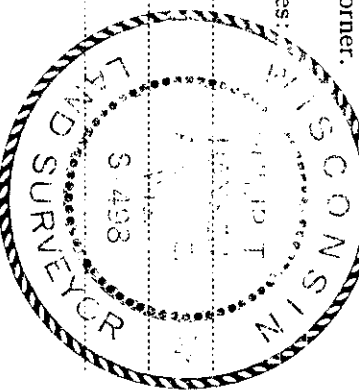

T35N R10E

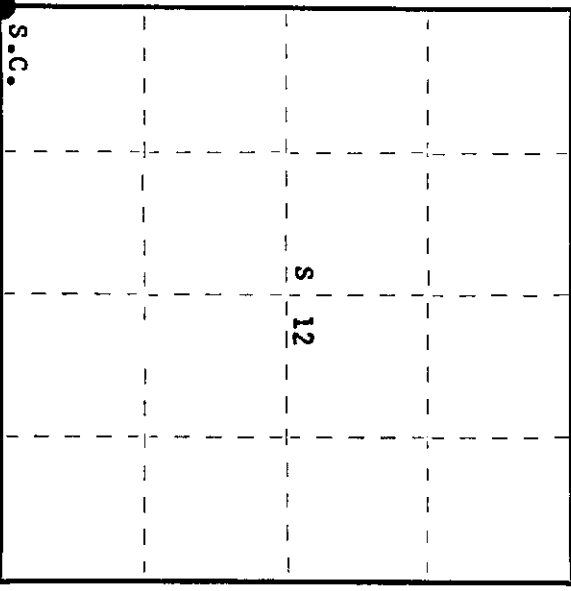

○ = Corner monument restored.

History of original corner establishment:

Corner established by James C. Nowlin, Government Deputy Surveyor, in 1865, from which Birch 6" bears N75°W, 13 links; birch 5" N35°E, 20 links.

Corner recovered by H.C. Lawrence, Registered Land Surveyor, in 1959. Set new cedar post by old one. No BT's.

Description of corner evidence found:

Recovered H.C. Lawrence's 4" cedar post, squared and scribed S11 - S12 - S13 - S14, standing in very poor condition.

OBT - white spruce 12" S62°W, 33.2 links, scribing partly visible
Lawrence has no record of this BT.

Description of monument and accessories I established to perpetuate the original location of this corner.

Replaced post with a 2 1/2" iron pipe with brass cap, stamped:
Projects 18" above ground.

Corner sets in alder swamp, nothing for BT's.

Set three 1 1/2" x 4" iron pipes for witness corners:

- #1 - S45°E, 25 links
 - #2 - North 40 links
 - #3 - East 30 links
- all project 18" above ground.
- T35N R10E
S.C. 11+12
14+13
CPI-1978

Dated at Rhinelander, Wis., this 30th day of March, 1978.

Signature Phillip T. Hansen Title Registered Land Surveyor Registration No. S-498
(County Surveyor, Registered Land Surveyor, or other duly authorized official)

Office of Register of Deeds, County of Oneida
Instrument was filed in this office for record on the 10th day of April, 1978
at 3:30 o'clock P. M. I hereby certify that the within

Doreen Savage Kuehn
(Register of Deeds)

By _____ Deputy

3510110006