

This form is intended to fulfill the requirements of Chapter A-E 7.08 (3)(a) thru (i) U.S. Public Land Survey Monument Location Record, Wisconsin Administrative Code. Use the reverse side of form for continuation.

U.S. PUBLIC LAND SURVEY MONUMENT LOCATION RECORD

Recorders Data

USPLS CORNER: WEST WITNESS MC SECTION: 14 TOWNSHIP: 35 NORTH RANGE: 10 EAST

NAME OF WATERWAY FOR M.C. CORNER : PELICAN LAKE SECTION LINE: NORTH

(CITY)(VILLAGE)(TOWN) OF: SCHOEPKE COUNTY OF: ONEIDA

Description of monument found or placed and all other evidence used as the basis for monument location; including monuments and related measurements required if the corner location was reestablished by lost corner proportionate methods. Also indicate name of original surveyor, original survey date and the corner monument, bearing trees, witness or other reference monuments established; including measured bearing and distance ties, from available records.

Found and accepted an old 2" dia. galvanized iron pipe with stamped brass cap 18" above grade. I left the undisturbed and plumb pipe monument in place; cap is stamped 'MC S11/S14 T35N R10E'.

In September 1865, James Nowlin/GLO set a wood post as the original corner and marked OBTs: a 5" Tamarack S70°W 38 links and a 12" Tamarack N55°W 35 links; all now obliterated. In January 1900, D.H. Vaughan notes he could not find the GLO MC post or OBTs as all burned off.


In November 1908, D.H. Vaughan set a wood post as a Witness MC on section line and marked a new BT 9" Pr N88°E 2.75 chains only as no other near, both now obliterated; and in June 1915, D.H. Vaughan ran West from his 1908 Witness MC post, no new BTs noted, per Page 9 of Old Field Book 8 in Oneida County survey records.

In 1949, N.M. Rowinski/RLS notes a monument? at this Witness MC corner location per Plat of Survey B-1849 in Oneida County survey records; presumably set in place of Vaughans 1908 MC post.

In 1985, Michael J. Romportl/RLS 1624 notes a 2.5" dia. capped iron pipe found at this Witness MC corner "as previously set by Rowinski", per Plat of Survey B-98 in Oneida County survey records.

This recovery completed September 29, 2001 and witnessed by adjoining owner Paul Schmidt at Fire No. 2361 Norway Point Road.

Plan view map of monument location with bearing and distance ties to a minimum of four(4) described witness or reference monuments of concrete, natural stone, iron, live bearing trees or equivalent material. If applicable, also show a minimum of two(2) bearing and distance ties to any other monument found and not accepted; including the bearing and distance from the accepted monument.

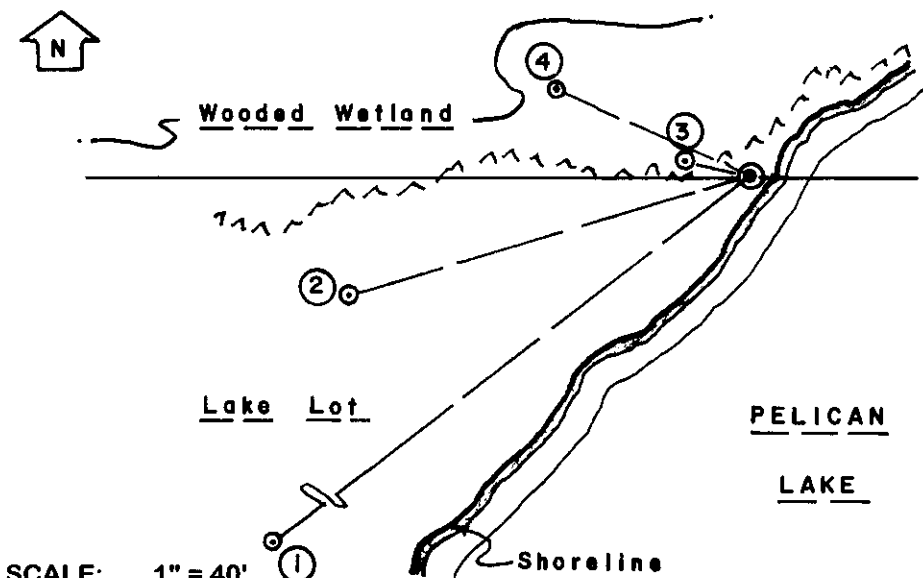

WITNESS MONUMENT TIES:

- ①- New BT 15" Tamarack S52°W at 154.95' in lake frontage yard area.
- ②- New BT 9" Tamarack S73°W at 87.03' in north edge of lake frontage yard area.
- ③- New BT 7" Bw tipped 20° North at N79°W 14.15'.
- ④- New BT SE 6" Mr of double N66°W 44.25'.

Standard white poly 'T' corner marker post set along NW side of corner monument found.

Corner falls about 3.5' West of Pelican Lake shoreline this date.

SCALE: 1" = 40'

Unless otherwise indicated, all bearing tree ties are to a .25" dia. by 2.5" long PK nail with a 1.25" dia. steel washer driven into unblazed right face and a .25" dia. by 2.5" long PK nail with a 2" dia. steel washer stamped BT is also driven into unblazed face of bearing tree at DBH; the basis for measured bearings is by compass to nearest degree and all tie distances are measured horizontal by steel tape corrected to nearest 1/100th feet at standard temperature of 68° F.


RLS SEAL:



LAND SURVEYOR CERTIFICATE:

I, William C. Rohde, hereby certify that I am duly licensed as a Professional Land Surveyor in the State of Wisconsin; that this USPLS monument location was determined by me and/or under my direct supervision and control; and that this U.S. Public Land Survey Monument Location Record is true and correct to the best of my knowledge and belief.

Signed *William C. Rohde*
William C. Rohde RLS 841

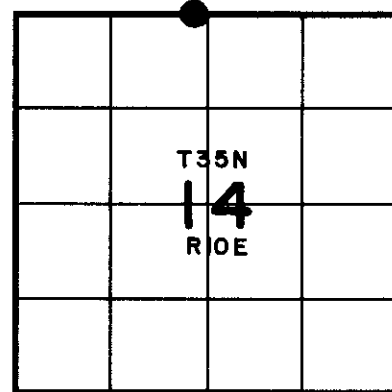

SECTION LOCATION MAP

INDEX NO.