

CERTIFIED LAND CORNER RESTORATION

Index No. H-21

State of Wisconsin



County of Oneida } ss.

I Philip T. Hansen, do hereby certify that on the 27th day of December, 1978, I found evidence of the S 1/16 corner of Section 11 & 12 Township 35, North, Range 10 East, Fourth Principal Meridian, as described hereon; and that from this evidence I established a new monument and accessories as described hereon to perpetuate the original location of this corner.

Resident witnesses:

Jim Clafflin

John Masbaum

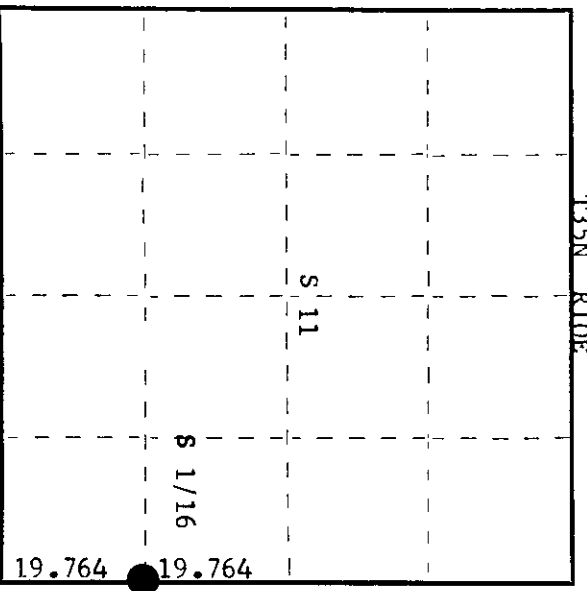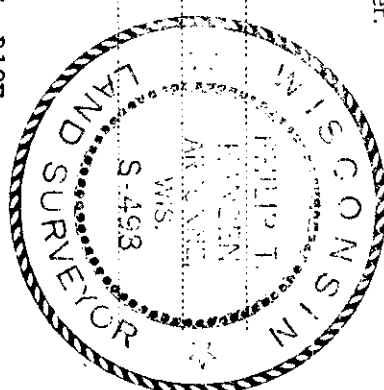

○ = Corner monument restored.

History of original corner establishment:

Corner established by N. Loftus, Ripco surveyor, in 1961. Ran random north bearing 358° 26' magnetic from SE corner, 39.40 chains to close out 17 1/2 links west of E 1/4 corner previously set.

Set new post at 19.764 chains which was 7.7 links east of someone's old 1/16 corner and H.C. Lawrence's new cedar post.

Marked NBT's - Maple 7" N12°W 45.9 links
Maple 10" S64°W 70 links

Corrected bearing N 1° 19' W.

Description of corner evidence found:

Recovered Ripco's 3/4" iron pipe with 2" diameter alloy cap in good condition.

H.C. Lawrence's cedar post bears N78°W 16.5 links from Ripco's pipe.

Recovered OBT's - Maple 7" N12°W (N2°W) 46.25 links, scribed BT - 1/16 S11.

Maple 10" S64°W (S70°W) 70.0 links, now a cut-off stump.

Monument projects 1 1/2' above ground. Cap stamped:

S 1/16
S11
S12

Description of monument and accessories I established to perpetuate the original location of this corner. Accepted Ripco's monument as they ran this line and corrected. Marked NBT - Maple 7" S88°W 38.7 links, scribed 1/16 BT.

Dated at Rhineclander, Wis. this 4th day of January, 1979.

Signature Philip T. Hansen Title Registered Land Surveyor Registration No. S-498
(County Surveyor, Registered Land Surveyor, or other duly authorized official)

Office of Register of Deeds, County of Oneida
Instrument was filed in this office for record on the 25th day of January, 1979
at 1:15 o'clock P. M.

Dorice Verlage Kuehn
(Register of Deeds)

By: _____ Deputy

1011000