


CERTIFIED LAND CORNER RESTORATION

Index No. H-19

State of Wisconsin } ss.  
County of Oneida

I Phillip T. Hansen do hereby certify that on the 9th day of October, 1978, I found evidence of the SC 1/16 corner of Section 11 Township 35, North, Range 10 East, Fourth Principal Meridian, as described hereon; and that from this evidence I established a new monument and accessories as described hereon to perpetuate the original location of this corner.

Resident witnesses:  
Jim Claffin  
Herb Wagoner

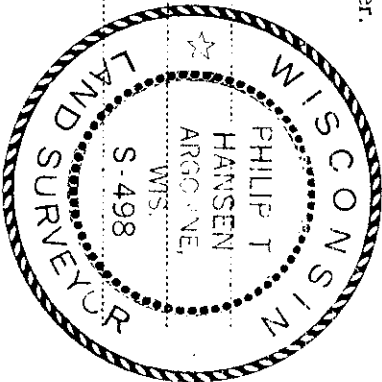


History of original corner establishment:  
Corner established by N. Loftus, Ripco surveyor, in 1960.  
Ran south from recovered C 1/4 corner. Set SC 1/16 at 19.48 chains.  
Marked NBT's -  
B. Spruce 3" S18°W, 25 1/2 links  
B. Spruce 4" S76°W, 36 1/2 links

Description of corner evidence found:  
Recovered Ripco's 3/4" iron pipe with 2" square brass cap, projecting 2' above ground.  
Cap stamped:

Recovered -  
B. Spruce 3" S18°W (S18°E) 25 links,  
scribed CS 1/16 S11 BT, this tree now dead  
B. Spruce 4" S76°W, 36.5 links,  
scribed CS 1/16 S11 BT.

Description of monument and accessories I established to perpetuate the original location of this corner.  
As monument was recovered in good condition, it was left in place as recovered.  
Marked NBT - N. Pine 7" S14°W, 23.0 links, scribed 1/16 BT.

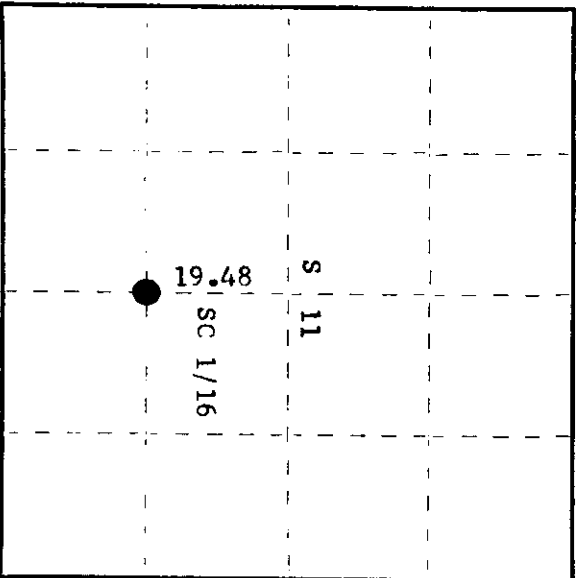

○ = Corner monument restored.

Dated at Rhineland, Wis. this 18th day of October, 1978

Signature Phillip T. Hansen Title Registered Land Surveyor Registration No. S-498  
(County Surveyor, Registered Land Surveyor, or other duly authorized official)

Office of Register of Deeds, County of Oneida  
at 10:05 o'clock A. M. 6th day of November, 1978  
I hereby certify that the within

Doris Verage Freese  
(Register of Deeds)

By: \_\_\_\_\_ Deputy

351011020