
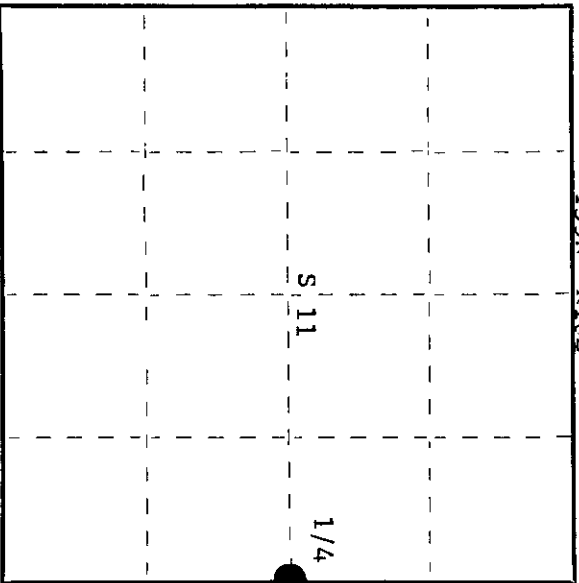


State of Wisconsin } ss.  
County of Oneida

I Phillip F. Hansen, do hereby certify that on the 27th day of December, 1978, I found evidence of the Quarter corner of Section 11 & 12 Township 35, North, Range 10 East, Fourth Principal Meridian, as described hereon; and that from this evidence I established a new monument and accessories as described hereon to perpetuate the original location of this corner.

Resident witnesses:  
Jim Clafflin  
John Masbaum

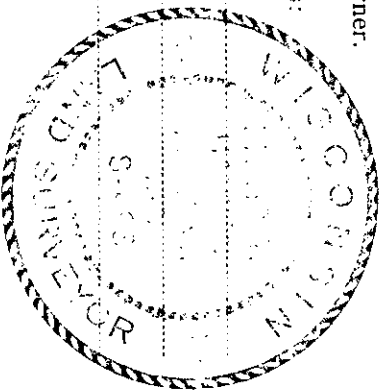

○ = Corner monument restored.

History of original corner establishment: Corner established by James L. Nowlin, Deputy Surveyor, in 1865, from which Birch 10" bears S11°W 15 links and Sugar 9" bears N54°E 20 links. B.F. Dorr, County surveyor, recovered corner in 1907. Marked W.Pine stump 16" N15°E 34 lks. Corner reset by H.C. Lawrence, Registered Land Surveyor - corner set wrong, relative to Dorr's W.Pine stump. Corner re-established by N.Lofthus in 1960. Ran E-W 1/4 line from W 1/4 - Recovered Dorr's W.Pine stump N10°E 34 links from point established. Lawrence's corner was 11.1 links south. Marked NBT's - Maple 15" S15°E 44 links; Hemlock 20" S18°W 47 links; Maple 16" N81°E 14 links.

Description of corner evidence found:

- Recovered Ripco's 2" iron pipe with 3" square brass cap in good condition.
- H.C. Lawrence's 5" square cedar post sets beside it.
- Recovered OBT's - Maple 16" N81°E 14.0 links, scribed S12 T35N R10 BT.
- Maple 15" (18") S15°E 44.0 links, scribed BT.
- Hemlock 20" (25") S18°W (S20°W) 47.0 links, scribed 1/4S BT.
- Dorr's W.Pine stump, badly rotted, N10°E 34.0 links.
- Monument projects 24". Cap stamped: T35N R10E S 11 S 11 1/2

Description of monument and accessories I established to perpetuate the original location of this corner. Left monument in place as recovered. Marked NBT - Sugar 8" N40°W 33.4 links, scribed 1/4 BT.

Dated at Rhineland, Wis., this 4th day of January, 1979.

Signature Phillip F. Hansen Title Registered Land Surveyor Registration No. S-498  
(County Surveyor, Registered Land Surveyor, or other duly authorized official)

Office of Register of Deeds, County of Oneida 25th day of January, 1979  
at 1:15 o'clock P. M. James A. ... Deeds Register  
I hereby certify that the within instrument was filed in this office for record on the 25th day of January, 1979.

George ...  
(Register of Deeds)

By: \_\_\_\_\_ Deputy