

CERTIFIED LAND CORNER RESTORATION

Index No. J-23

State of Wisconsin

County of Oneida

ss.

I Phillip T. Hansen

, do hereby

certify that on the 15th day

of March, 1978, I found

evidence of the Quarter

corner of Sections 12 & 13

Township 35, North, Range

10 East, Fourth Principal Meridian,



as described hereon; and that from this evidence I established a new monument and accessories as described hereon to perpetuate the original location of this corner.

Resident witnesses:

Glen Barker

Jim Claflin

Herb Wagoner

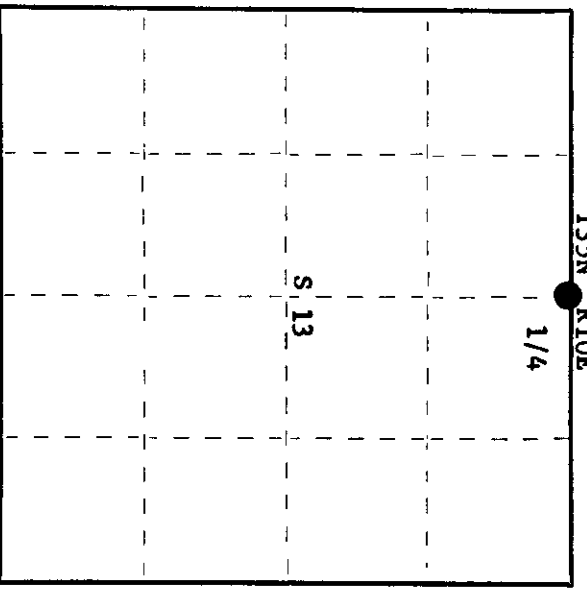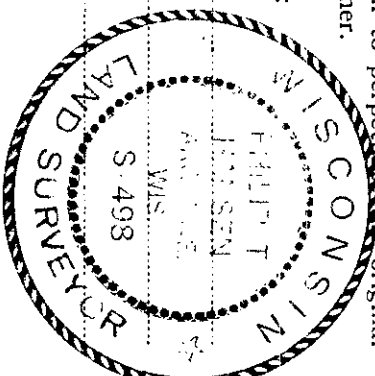

History of original corner establishment:

Original corner established by James C. Nowlin, Deputy Surveyor, in 1865, from which tamarack 8" bears N40°E, 18 links; tamarack 10" bears S30°E, 9 links.

Corner recovered in 1949 by H.C. Lawrence, Registered Land Surveyor, identified by point of original stake and remains of tamarack 10" S30°E, 9 links with BT scribe marks.

Set 4" tamarack post and marked NBT's - tamarack 7" N20°W, 21 1/2 links; tamarack 7" S6°E, 47 links

Description of corner evidence found:

Recovered H.C. Lawrence's 4" squared tamarack post down under snow, scribling 1/4S are the only legible marks.

Found post point frozen in ice and muck.

Recovered OBT's - tamarack 7" (8") N20°W, 21 1/2 links, scribling grown over tamarack 7" (8") S6°E, 47 links, scribling grown over

Description of monument and accessories I established to perpetuate the original location of this corner.

Replaced post point with a 2 1/2" Berntsen A-1 Federal Monument with alloy cap, stamped:

Projects 18" above ground.

NBT's - Tamarack 12" N39°E, 60.4 links
Tamarack 10" S78°W, 81.5 links
scribled 1/4 BT

S498
T35N R10E
1/4 S12
S13
1978

Dated at Rhinelander, Wis., this 4th day of April, 1978

Signature Phillip T. Hansen Title Registered Land Surveyor Registration No. S-498
(County Surveyor, Registered Land Surveyor, or other duly authorized official)

Office of Registrar of Deeds, County of Oneida
at 10:30 o'clock AM, I hereby certify that the within instrument was filed in this office for record on the 16th day of April, 1978

Debra Terzagge Kuehn
(Register of Deeds)

By _____ Deputy

3510120820