


CERTIFIED LAND CORNER RESTORATION


Index No. **F-25**

State of Wisconsin } ss.
 County of Oneida }

I Philip T. Hansen, do hereby certify that on the 13th day of August, 1975, I found evidence of the N-1/16 corner of Sections 7 and 12 Township 35, North, Range 10 and 11 East, Fourth Principal Meridian, as described hereon; and that from this evidence I established a new monument and accessories as described hereon to perpetuate the original location of this corner.

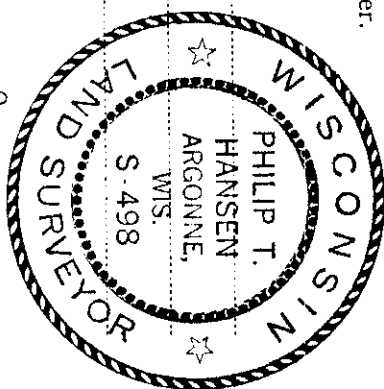

Resident witnesses:

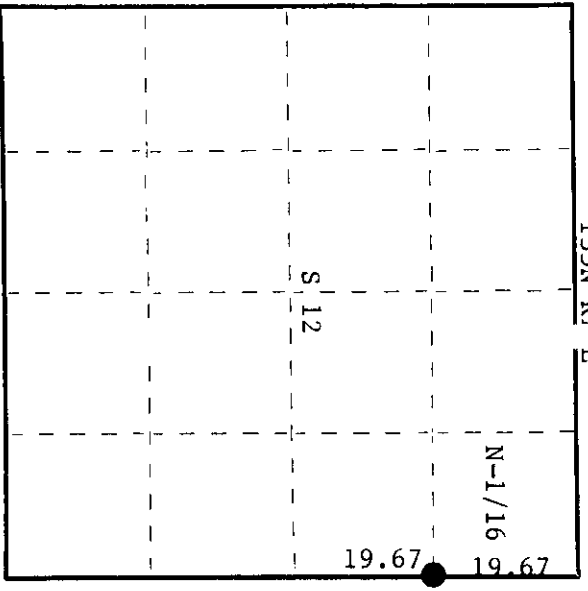

O = Corner monument restored.

History of original corner establishment: Corner restored by H.C. Lawrence, Registered Land Surveyor, in 1949, during his retracement survey. He recovered a crude stake scribed 1/8 on east side of section line road at 19.62 chains south of section corner. Measurement to 1/4 corner 39.34 chains. Set new post at 19.67 48 links east of center line of road. Marked NBT's - tamarack 6" N74°E 21½ links and white pine 10" N2°W 39 links.

Description of corner evidence found:

Recovered a 3" cedar post, squared and scribed N-1/16 S7, N-1/16 S12 in poor condition; also an old cedar point buried in the muck beside it.

Recovered OBT - Tamarack 6" N74°E 21.5 links scribed S7 BT
 White pine 10" (12") N02°W 39 links scribed 1/16 BT

Description of monument and accessories I established to perpetuate the original location of this corner.
 Replaced wooden stake with 1-1/2" iron pipe with 2" brass cap stamped -

No additional accessories established.

R	S498	R
10	S12 S7	11
E	N-1/16	E

CPI-1975

Dated at Rhineland, Wis., this 8th day of September, 1975.

Signature Philip T. Hansen Title Registered Land Surveyor Registration No. S-498
 (County Surveyor, Registered Land Surveyor, or other duly authorized official)

Office of Register of Deeds, County of Oneida I hereby certify that the within instrument was filed in this office for record on the 14th day of October, 1975 at 2:00 o'clock P. M.

Dennis George Fuchs
 (Register of Deeds)

By: _____ Deputy

3510123000