

CERTIFIED LAND CORNER RESTORATION



State of Wisconsin }
 County of Oneida } ss.

I, Philip T. Hansen, do hereby certify that on the 3rd day of September, 1975, I found evidence of the EC 1/16 corner of Section 13, Township 35 North, Range 10 East, Fourth Principal Meridian, as described hereon; and that from this evidence I established a new monument and accessories as described hereon to perpetuate the original location of this corner:

Description of original monument and accessories and subsequent restorations: Corner established by H. C. Lawrence, Registered Land Surveyor in 1949. He ran east from the iron pipe at C₁, a distance of 44.26 chains to center line of range line road. At 22.13 chains he set a witness post, 100 lks north of centerline of highway 2, from which sugar 16" bears N 35° W 8 lks and oak 8" bears south 50 lks.


Description of corner evidence found: Recovered a 4" cedar post, squared and scribed EC 1/16 S 13 W.C. 1 Ch.N. in fair condition.

Recovered OBT Sugar 16" (17") N 35° W 8 lks (9) scribed W.C.
Oak 8" south 50 lks (50.5 lks) scribing grown over.

Description of monument and accessories I established to perpetuate the location of this corner:

Replaced 4" cedar post with 1 1/2" OD iron pipe w/2" brass cap stamped
 No additional accessories required.

S 498
 T 35 N R 10 E
 S/13
 EC 1/16 W.C.
 S 1 ch.
 GPI 1975

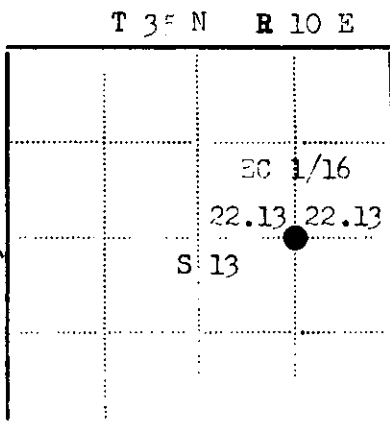

● - Corner monument restored
 □ -

Resident witnesses Glen Barker and Jia Claflin

Dated at Rhineland Wisconsin, this 16 day of September 1975.

Signature Philip T. Hansen Title Reg. Land Surveyor
 (County Surveyor, Registered Land Surveyor, or other duly authorized official)

Surveyors Registration No. S-498

Office of Register of Deeds County of Oneida

I hereby certify that the within instrument was filed in this office for record on the 14th day of October, 1975, and was filed in Book No. _____ Page No. _____ of County Records.

Signature Doris Verage Kuehn Title Register of Deeds

Township 35 North, Range 10 East, Section 13, Index No. _____, Page No. _____

3510132010

1-27