

CERTIFIED LAND CORNER RESTORATION

Index No. **K-23**

State of Wisconsin

County of Oneida } ss.

I Phillip T. Hansen, do hereby certify that on the 15th day of March, 1978, I found evidence of the N 1/16 corner of Section 13

Township 35, North, Range 10 East, Fourth Principal Meridian,



as described hereon; and that from this evidence I established a new monument and accessories as described hereon to perpetuate the original location of this corner.

Resident witnesses:

Glen Barker

Jim Claflin

Herb Wagoner

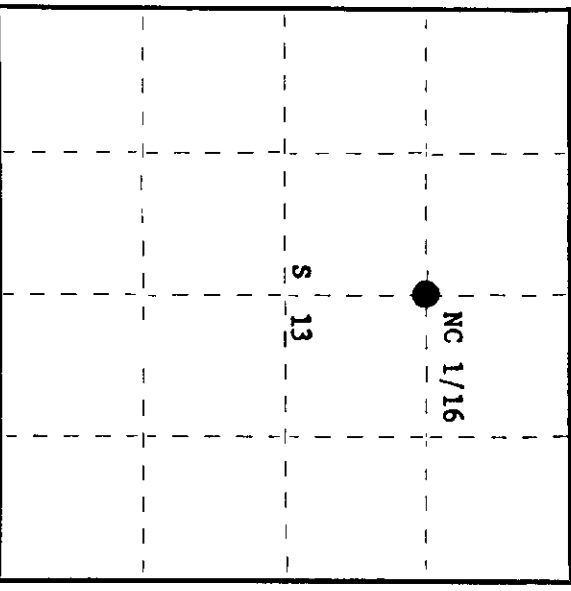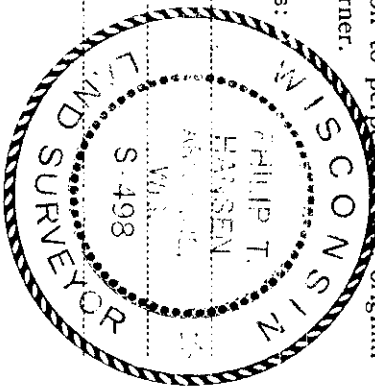

History of original corner establishment:

H.C. Lawrence, Registered Land Surveyor, in 1949 recovered old post and iron pipe. Found the remains of old cedar stump BT which bears N 47° E, 19.5 links. Set 4" cedar post in old post hole and made NBT's - Oak 6" S63°E, 41 1/2 links; Sugar 4" N42°E, 17 links.

Description of corner evidence found:

Recovered H.C. Lawrence's 4" cedar post, squared and scribed NC 1/16 - S13 - NC 1/16 - S13, standing in fair condition.
Recovered old BT's - Oak 6" (12") S63°E, 41 1/2 links, scribing grown over Sugar 4" (6") N42°E, 17 links, scribing grown over

Description of monument and accessories I established to perpetuate the original location of this corner.

Replaced post with a 1 1/2" iron pipe with brass cap, stamped: Projects 24" above ground.

NBT - Maple 6" S54°W, 36.1 links
scribed 1/16 BT
S498
T35N R10E
NC 1/16 S-13
CPI-1978

Dated at Rhinelander, Wis., this 4th day of April, 1978

Signature Phillip T. Hansen Title Registered Land Surveyor Registration No. S-498
(County Surveyor, Registered Land Surveyor, or other duly authorized official)

Office of Register of Deeds, County of Oneida
Instrument was filed in this office for record on the 16th day of April, 1978
at 10:30 o'clock A. M.

Thomas George Kuehner
(Register of Deeds)

By _____ Deputy

351013 3020