

U.S. PUBLIC LAND SURVEY MONUMENT RECORD


Note: This form is intended and designed to fulfill all requirements of Wisconsin Administrative Code, Chapter A-E 7.08 U.S. Public Land Survey Monument Record (3)(a)(b)(c)(d)(e)(f)(g)(h)(i). An additional sheet may be added if necessary to conform with said requirements.

(a) CORNER LOCATION:

Oneida County

State Plane Coordinates

SE corner of Sec. 16 X 118814.628
 Township 35 North Y 308883.014
 Range 10 East Datum Base _____
 Town/City ~~Enterprise/Schoepke~~ County of Oneida

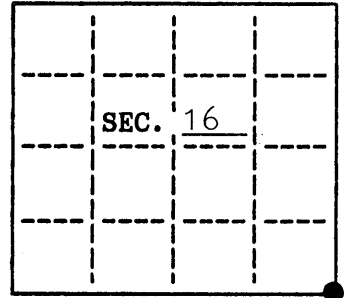


(b) HISTORY OF ORIGINAL CORNER ESTABLISHMENT

Original Surveyor: James Nowlin Original B.T.'s
 Date of Survey: Commenced 1865 12" Tamarack S 56°W 100 Lks.
 Completed 1865 8" Tamarack N 70°E 50 Lks.

(b)(f)(g)(h) Description of monument found at this corner and if it was accepted, state all evidence (material, testimonial, occupational, plats, records, other monuments) used as a basis for accepting. If not accepted or if nothing was found, state evidence used as basis for establishing location. If reestablished through lost corner proportionate methods, indicate all monuments, distances and directions used to establish. Indicate type of monument and sign post found or set.

- 1949 F.R. Wincentzen found corner in road, and old B.T.'s 217' east to 5"X5" post m.c. E 1/4 Sec.21, 2622.80' south (see Genisot map 627-1)
- 1967 F.R. Wincentzen, County Surveyor, set corner in road
- 1990 Kelly found iron below surface of road. Set R/R spike over iron. Set alum. mon. east of corner. Set post next to mon. marked bearing trees.
- Oct.2004 I reset corner after road construction, by G.P.S. coordinates given by Oneida Co. L.I.O. Base station was harn.#239s using Trimble 5700,5800. I found Kelly's wit.mon. to be 0.4' out from my position and no other B.T.'s were found. My 8" Norway N 50° E could have been an old B.T. from Kelly however I found no evidence of a nail (as he stated). Made new B.T.'s as shown below.


(c)(d)(e) Plan view of corner with ties to at least 4 witness monuments. If in disagreement with previously established corner, show the distances between the two corners and also indicate the ties to the disputed.

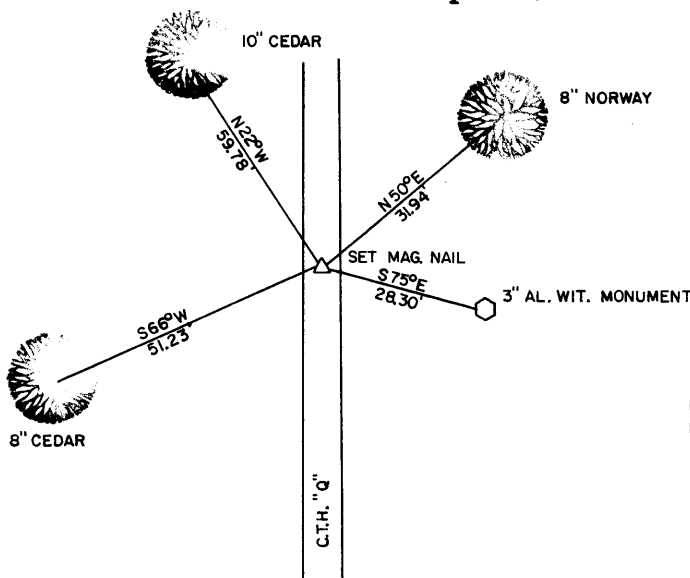

DISTANCES TO SPIKE IN SIDE OF TREE
 NO SCALE
 BEARINGS TAKEN WITH HANDHELD COMPASS

(i) I, Russell F. Brown
 hereby certify that the corner location on this record was determined by me or under my direction and control and that this U.S. Public Land Survey Monument Record is correct and complete to the best of my knowledge and belief.

Russell F. Brown 12/17/04
 Signature Date

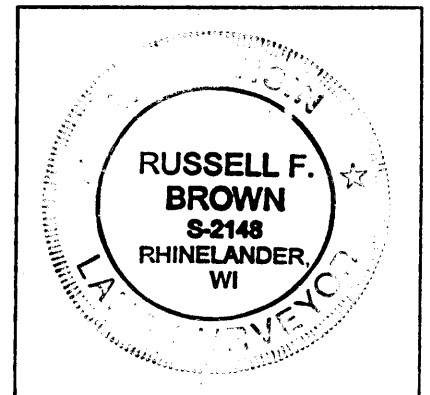

INDEX NO. 113

3510160000