


U.S. PUBLIC LAND SURVEY MONUMENT RECORD

Note: This form is intended and designed to fulfill all requirements of Wisconsin Administrative Code, Chapter A-E 7.08 U.S. Public Land Survey Monument Record (3) (a) (b) (c) (d) (e) (f) (g) (h) (i). An additional sheet may be added if necessary to conform with said requirements.

(a) Corner location: Township 35 North
 Range 10 East/West

Town/City/Village Enterprise

County Oneida

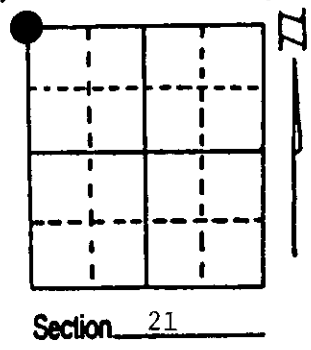

(b) (f) (g) (h) Description of monument found at this corner and if it was accepted, state all evidence (material, testimonial, occupational, plats, records, other monuments) used as a basis for accepting. If not accepted or if nothing was found, state evidence used as basis for establishing location. If reestablished through lost corner proportionate methods, indicate all monuments, distances and directions used to establish. Indicate type of monument found or set and sign post.

1865 - James Nowlin established this corner at 80.00 chains and set a wood post with two BTs:

4" Fir, N60°E, 4 Links (2.64') 3" Spruce, N40°W, 5 Links (3.30')


5/24/1995 - Milo E. Stefan found an aluminum monument with an old scribed cedar post. Monument stamped as set by Loftus. Cedar post I think is by Consolidated 30 - 40 years ago. Also, BTs in place.

We made one new BT and set plastic sign post.

(c) (d) (e) Plan view of corner with ties to at least 4 witness monuments. If in disagreement with previously established corner, show the distances between the two corners and also indicate the ties to the disputed corner.

- 1) 2" x 30" Aluminum Monument
- 2) 20" Hemlock, N48°E, 40.82'
- 3) 14" Sugar Maple, S63°E, 22.45'
- 4) 8" Sugar Maple, S14°W, 112.97'
- 5) 6" Blasam Fir, N80°W, 20.74'
- 6) Plastic Sign Post, NE, .75'

Distances to nail in side of BTs.
 Stump blaze scribed BT.
 BT tags to face of each BT.

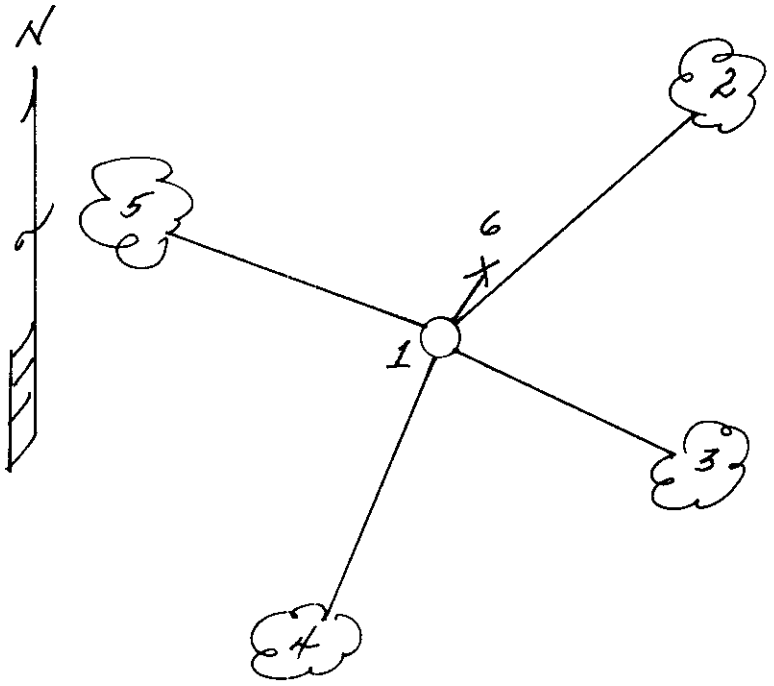

REGISTER OF DEEDS OFFICE
 ONEIDA COUNTY, WIS
FILED
 JUL 11 1995
 At _____ O'Clock _____ M
THOMAS H. LEIGHTON
 REGISTER OF DEEDS

(i) I, Milo E. Stefan
 (type or print name) certify that the corner location on this record was determined by me or under my direction and control and that this U.S. Public Land Survey Monument Record is correct and complete to the best of my knowledge and belief.

Milo E. Stefan July 10, 1995
 Signature Date



3510170000

Index No. N-9