

CERTIFIED LAND CORNER RESTORATION

Index No. R-3

State of Wisconsin



County of Oneida } ss.

I, Phillip T. Hansen, do hereby certify that on the 7th day of November, 1978, I found evidence of the Quarter corner of Section 19 & 30 Township 35, North, Range 10 East, Fourth Principal Meridian, as described hereon; and that from this evidence I established a new monument and accessories as described hereon to perpetuate the original location of this corner.

Resident witnesses:

Jim Clafflin

Herb Wagoner

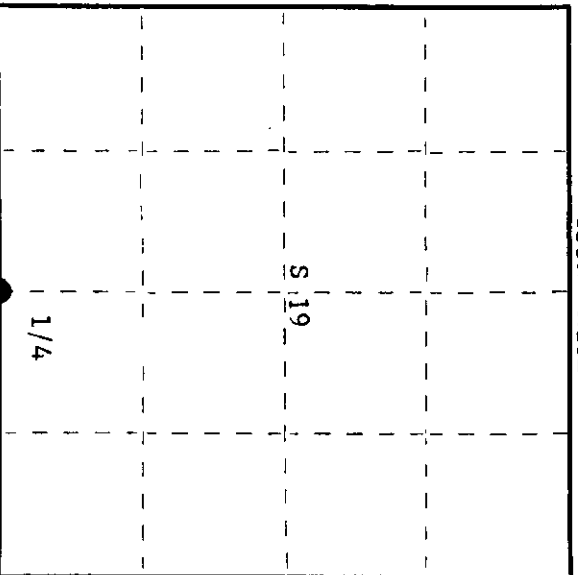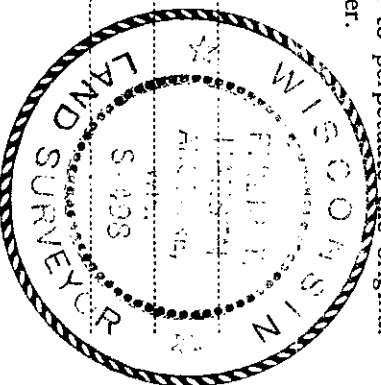

○ = Corner monument restored.

History of original corner establishment:

Corner recovered by Drivas and crew, Ripco surveyors, in 1961.  
Set new post and marked NBT's -  
Balsam 5" S 70° E 13½ links  
Aspen 9" N19° E 45 links

Description of corner evidence found:

Recovered Ripco's 2" iron pipe with 3" diameter alloy cap. Part of the cap was broken off.  
Also recovered an old 5" square cedar post scribed 1/4S beside the iron monument.  
Recovered ORT's -  
Aspen 9" (14") N19°E 45.0 links, now a dead snag, scribed 1/4S S19 BT.  
Balsam 5" (8") S7°E 13.5 links, scribing grown over.

Description of monument and accessories I established to perpetuate the original location of this corner.

Replaced Ripco's monument with 2½" Berntsen A-1 Federal Monument (O.C.C.) projecting 8" above ground. Cap stamped:  
Corner sets on west edge of old road bed which runs N-S through swamp.  
Marked NBT's -  
Sugar 5" S38°W 13.0 links  
Maple 6" N26°W 35.7 links  
W. Birch 6" N40°E 42.1 links  
all scribed 1/4 BT

T35N R10E  
S 19  
1/4  
S 19  
S 30  
S498-1978

Dated at Rhinelander, Wis., this 27th day of November, 1978

Signature: Phillip T. Hansen Title Registered Land Surveyor Registration No. S-498  
(County Surveyor, Registered Land Surveyor, or other duly authorized official)

Office of Register of Deeds, County of Oneida  
I hereby certify that the within instrument was filed in this office for record on the 4th day of December, 1978 at 1:35 o'clock P. M.

Dorrie Verage Kuehn  
(Register of Deeds)

By: \_\_\_\_\_ Deputy

020 000 10153