

CERTIFIED LAND CORNER RESTORATION


Index No. P-5

State of Wisconsin }
 County of Oneida } ss.


I Phillip T. Hansen, do hereby certify that on the 7th day of November, 1978, I found evidence of the Quarter corner of Section 19 & 20 Township 35, North, Range 10 East, Fourth Principal Meridian, as described hereon; and that from this evidence I established a new monument and accessories as described hereon to perpetuate the original location of this corner.

Resident witnesses:

Jim Clafflin
Herb Wagoner

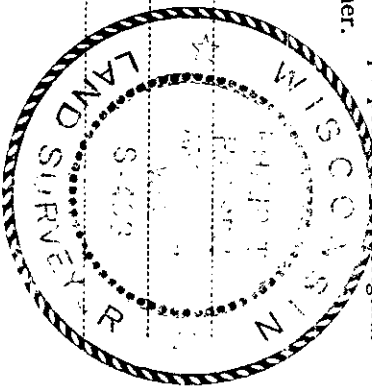

T35N R10E

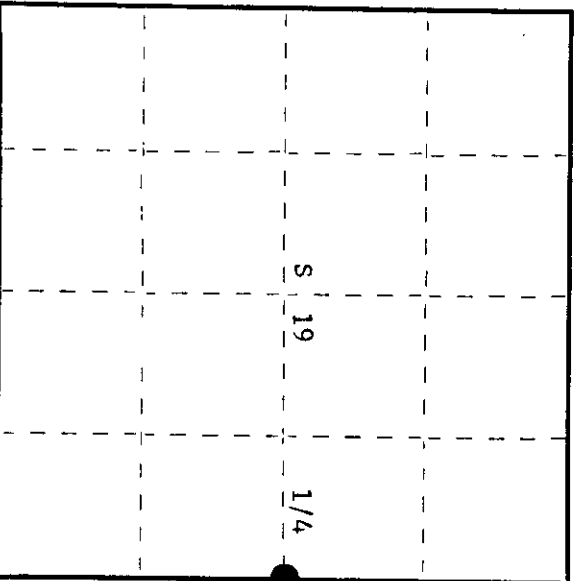

○ = Corner monument restored.

History of original corner establishment:

Original corner established by James W. Nowlin, Deputy Surveyor, in 1865 from which cedar 13" bears S 81° E 20 links; tamarack 12" bears N 60° W 25 links.

Corner recovered and remonumented by Drivas and crew, Ripco surveyors, in 1961.

Set iron pipe and marked NBT's -
 Maple 8" S16°W 23½ links
 Maple 6" S74°W 54½ links

Description of corner evidence found:

Recovered Ripco's 2" iron pipe with 3" diameter alloy cap. Also an old 5" square cedar post beside it. A fence line (down) runs south from this corner.

Recovered OBT's - Maple 8" S16°W 23.5 links,

scribing grown over
 Maple 6" (8") S74°W 54.25 links, (53.5 links)

Monument projects 2½ feet, cap stamped:

T35N R10E
 S19 + S20
 1/4

RIPCO

Description of monument and accessories I established to perpetuate the original location of this corner.

Left monument in place as recovered.

Marked NBT's - Maple 6" N42°W 50.1 links
 W. Birch 6" N67°E 29.9 links
 both scribed 1/4 BT

Dated at Rhineland, Wis., this 27th day of November, 1978

Signature Phillip T. Hansen Title Registered Land Surveyor Registration No. S-498
 County Surveyor, Registered Land Surveyor, or other duly authorized official

Office of Register of Deeds, County of Oneida. I hereby certify that the within instrument was filed in this office for record on the 4th day of December, 1978 at 1:35 o'clock P.M.

Doris Leauge Kuehn
 (Register of Deeds)

By Doris Leauge Kuehn Deputy