

CERTIFIED LAND CORNER RESTORATION

Index No. P.3



State of Wisconsin }
County of Oneida } ss.

I, Phillip T. Hansen, do hereby
certify that on the 19th day
of October, 1978, I found
evidence of the C 1/4
corner of Section 19
Township 35, North, Range
10 East, Fourth Principal Meridian,
as described hereon; and that from this evidence
I established a new monument and accessories
as described hereon to perpetuate the original
location of this corner.

Resident witnesses:

Jim Clafflin

Herb Wagoner

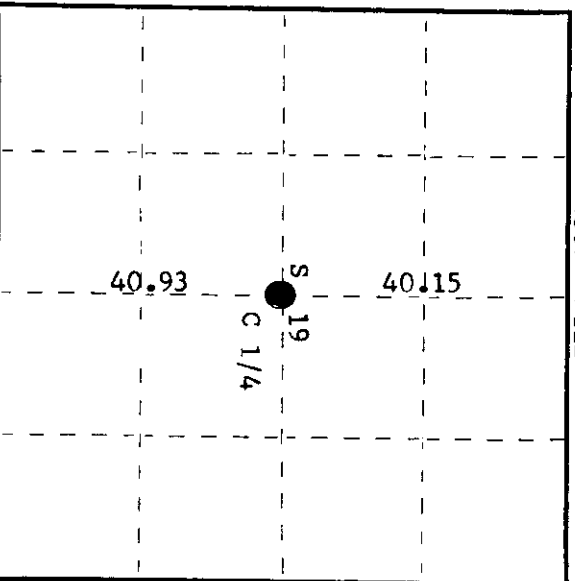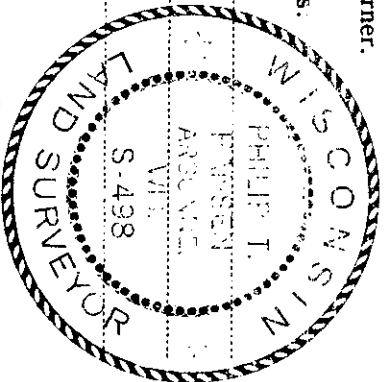

○ = Corner monument restored.

History of original corner establishment:

Corner established by Drivas, Ripco surveyor, in 1961.
Ran N-S and E-W 1/4 lines. Established C 1/4 corner at 40.93 chains N 3° 41' 25" W of
S 1/4 corner.

Set new pipe and marked NBT's -
Balsam 6" S82°E 34 links
Balsam 6" N0°E 11 1/2 links

Description of corner evidence found:

Recovered Ripco's 2" iron pipe with 3" diameter alloy cap in good condition.

Recovered OBT's -

Balsam 6" S82°E 34.0 links, now a stump

Balsam 6" north 11.25 links, now a dead snag, scribed C 1/4 S19 BT

Monument projects 24" above ground. Cap stamped:

T35N R10E
C 1/4
S19
RIPCO

Description of monument and accessories I established to perpetuate the original location of this corner.
As monument was found in good condition, it was left as recovered.

Marked NBT's -

Black Spruce 8" S2°W 72.4 links

Balsam 7" S65°W 27.8 links

Balsam 8" S62°E 48.3 links

all scribed C 1/4 BT

Dated at Rhinelander, Wis., this 13th day of November, 19 78

Signature Phillip T. Hansen Title Registered Land Surveyor Registration No. S-498
(County Surveyor, Registered Land Surveyor, or other duly authorized official)

Office of Register of Deeds, County of Oneida, I hereby certify that the within
instrument was filed in this office for record on the 27th day of November, 19 78
at 10 o'clock A.M.

Donna George Kinsler
(Register of Deeds)

By: _____ Deputy

3510192020