



CERTIFIED LAND CORNER RESTORATION

Index No. P.2

State of Wisconsin }
County of Oneida } ss.

I Phillip T. Hansen, do hereby certify that on the 20th day of October, 1978, I found evidence of the WC 1/16 corner of Section 19 Township 35, North, Range 10 East, Fourth Principal Meridian, as described hereon; and that from this evidence I established a new monument and accessories as described hereon to perpetuate the original location of this corner.

Resident witnesses:
Jim Clafin
Herb Wagoner

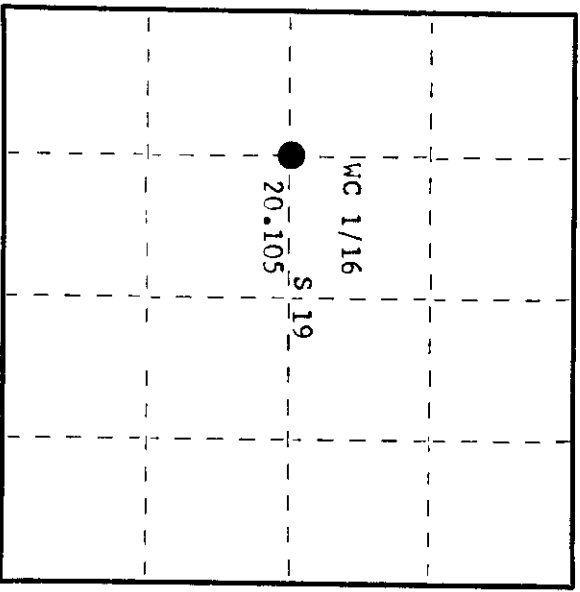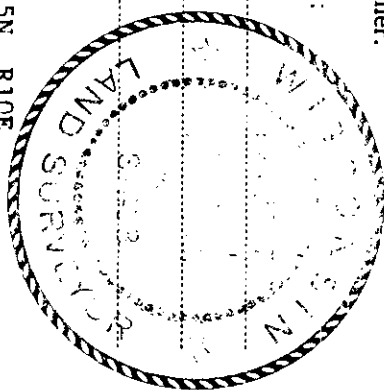

○ = Corner monument restored.

History of original corner establishment:

Corner established by Drivas, Ripco surveyor, in 1961. Ran N-S and E-W 1/4 lines to establish the C 1/4 corner. Set WC 1/16 corner at 20.105 chains N 87° 42' W of C 1/4 corner.

- Marked NBT's -
Maple 5" N41°W 13 links
Maple 4" N62°E 91-3/4 links
Maple 6" S35°W 30-1/2 links

Description of corner evidence found:

Recovered Ripco's 3/4" iron pipe with 2" diameter alloy cap, poorly set.

Recovered Maple 5" N41°W 13.0 links, scribing grown over

Maple 4" N62°E (N72°E) 91.75 links

Maple 6" S35°E 30.5 links, scribed CW 1/16 S19 BT

Cap stamped:

CW 1/16 +
RIPCO

Description of monument and accessories I established to perpetuate the original location of this corner. Reset Ripco's iron pipe to check calls to BT's. Monument now projects 18" above ground. No additional accessories established.

Dated at Rhinelander, Wis., this 27th day of November, 1978

Signature Phillip T. Hansen Title Registered Land Surveyor Registration No. S-498
(County Surveyor, Registered Land Surveyor, or other duly authorized official)

Office of Register of Deeds, County of Oneida. I hereby certify that the within instrument was filed in this office for record on the 4th day of December, 1978 at 1:35 o'clock P. M.

Doris Verage Fuehr
(Register of Deeds)

By Doris Verage Fuehr Deputy

3510192030