

CERTIFIED LAND CORNER RESTORATION


Index No. 0-3

State of Wisconsin


County of Oneida } ss.

I Philip T. Hansen, do hereby certify that on the 19th day of October 19 78, I found evidence of the NC 1/16 Section 19 corner of Township 35 North, Range 10 East, Fourth Principal Meridian, as described hereon; and that from this evidence I established a new monument and accessories as described hereon to perpetuate the original location of this corner.

Resident witnesses: Jim Clafflin Herb Wagoner

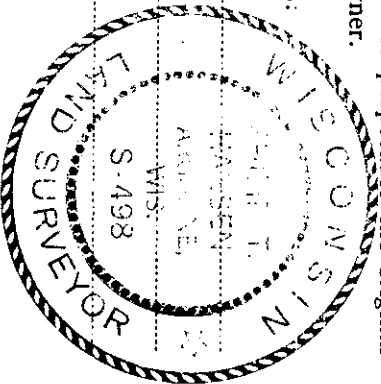

T35N R10E

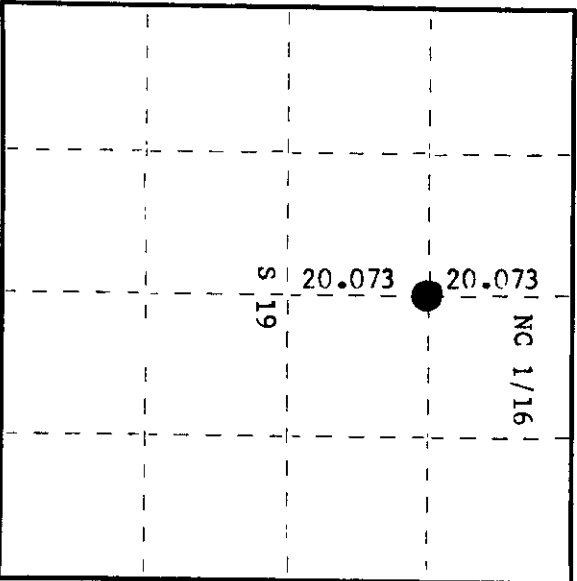

○ = Corner monument restored.

History of original corner establishment:

Corner established by Drivas, Ripco surveyor, in 1961. Ran N-S and E-W 1/4 lines to establish the C 1/4 corner. C 1/4 sets 40.14/75 S 3° 41' 25" E of N 1/4 corner. Set NC 1/16 at 20.073 chains intermediate.

Marked NBT's - Cedar 6" S64°W 52 1/2 links Tam. 4" S54°E 53.6 links

Description of corner evidence found:

Recovered Ripco's 3/4" iron pipe with a 2" diameter alloy cap in good condition. There is also a 1/2" iron pipe driven beside it. Recovered OBT's - Tamarack 4" (7") S54°E, 53.6 links, scribing partly legible. Cedar 6" (9") S64°W (S72°W) 52.5 links, scribing partly legible. Monument projects 24" above ground. Cap stamped: CN 1/16 RIPCO

Description of monument and accessories I established to perpetuate the original location of this corner. Monument left in place as recovered. No additional accessories established.

Dated at Rhinelander, Wis., this 13th day of November, 1978

Signature: Philip T. Hansen, Title: Registered Land Surveyor, Registration No. S-498

Office of Register of Deeds, County of Oneida. I hereby certify that the within instrument was filed in this office for record on the 27th day of November, 1978 at 11:00 o'clock P.M.

Arund Lennarz, Register of Deeds

By: Deputy

3510193020