

CERTIFIED LAND CORNER RESTORATION

Index No. 0-2

State of Wisconsin

County of Oneida



ss.

I, Phillip T. Hansen, do hereby certify that on the 7th day of November, 1978, I found evidence of the NW 1/16 corner of Section 19 Township 35 North, Range 10 East, Fourth Principal Meridian, as described hereon; and that from this evidence I established a new monument and accessories as described hereon to perpetuate the original location of this corner.

Resident witnesses:

Jim Claffin

Herb Wagoner

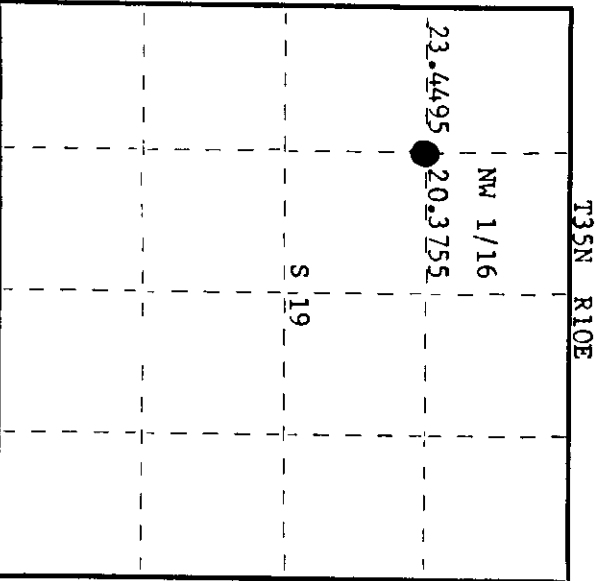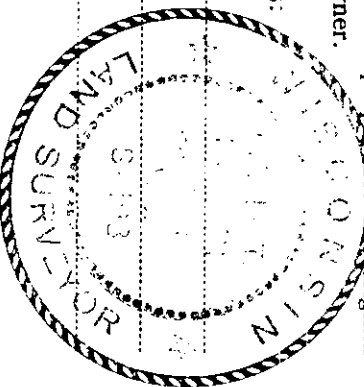

History of original corner establishment:

Corner established by Drivas and crew, Ripco surveyors, in 1961. Ran random line west from NC 1/16 corner bearing 272° 00' 09" magnetic 43.825 chains to close out 16 links south of N 1/16 corner. Set NW 1/16 corner at 20.3755 chains, 8 links north.

Marked NBT's -
Cedar 6" S86°E 9.5 links
Cedar 8" S71°W 26 links

Description of corner evidence found:

Recovered Ripco's 3/4" iron pipe with 2" diameter alloy cap in good condition.

Recovered OBT's -

Cedar 6" S86°E (S83°E) 9.5 links (11.2 links)

scribed NW 1/16 S19.

Cedar 8" (9") S71°W 26.0 links (24.6 links)

scribed NW 1/16 S19.

Monument projects 12" above ground. Cap stamped:

NW 1/16 S 19

RIPCO

Description of monument and accessories I established to perpetuate the original location of this corner.
No additional accessories established.

Dated at Rhineland, Wis., this 27th day of November, 1978

Signature: Phillip T. Hansen Title: Registered Land Surveyor Registration No. S-498
(County Surveyor, Registered Land Surveyor, or other duly authorized official)

Office of Register of Deeds, County of Oneida. I hereby certify that the within instrument was filed in this office for record on the 4th day of December, 1978 at 1:35 o'clock P. M.

Doris Berge Fuchs
(Register of Deeds)

By: _____ Deputy

3510193030