U.S. PUBLIC LAND SURVEY MONUMENT RECORD

NOTE: This form is intended and designed to fulfill all requirements of Wisconsin Administrative Code, Chapter A-E 7.08 U.S. Public Land Survey Monument Record (3)(a)(b)(c)(d)(e)(f)(g)(h)(i). An additional sheet may be added if necessary to conform with said requirements.

(a) Corner location: Township 35 North

Range 10 East

Town of ENTERPRISE

ONEIDA County, Wisconsin

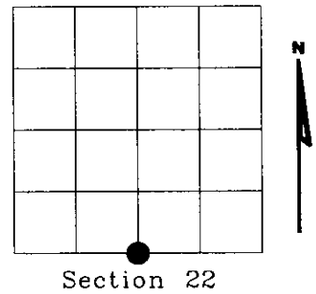

(b)(f)(g)(h) Description of monument found at this corner and if it was accepted, state all evidence (material, testimonial, occupational, plats, records, other monuments) used as a basis for accepting. If not accepted or if nothing was found, state evidence used as basis for establishing location. If reestablished through lost corner proportionate methods, indicate all monuments, distances and directions used to establish. Indicate type of monument found or set and sign post.

1865 - JAMES L. NOWLIN, SET 1/4 SECTION POST, AND SET B.T.'S:
-BIRCH 20, S 20° E, 15 LKS.
-BIRCH 15, N 36° W, 35 LKS.

1976 - BOB WINAT, SET 2" DIAMETER IRON PIPE AND MADE 3 B.T.'S WITH NAILS IN THE SIDES OF TREES.

2000 - I FOUND 2" DIAMETER IRON PIPE AND 3 B.T.'S WITH NAILS IN THE SIDE OF TREES, AND SET NEW B.T. AS SHOWN IN SKETCH BELOW. REPLACED 2" IRON PIPE WITH 3" DIAMETER ALUMINUM TABLET STAMPED TO IDENTIFY CORNER.

(c)(d)(e) Plan view of corner with ties to at least 4 witness monuments. If in disagreement with previously established corner, show the distances between the two corners and also indicate the ties to the disputed corner.

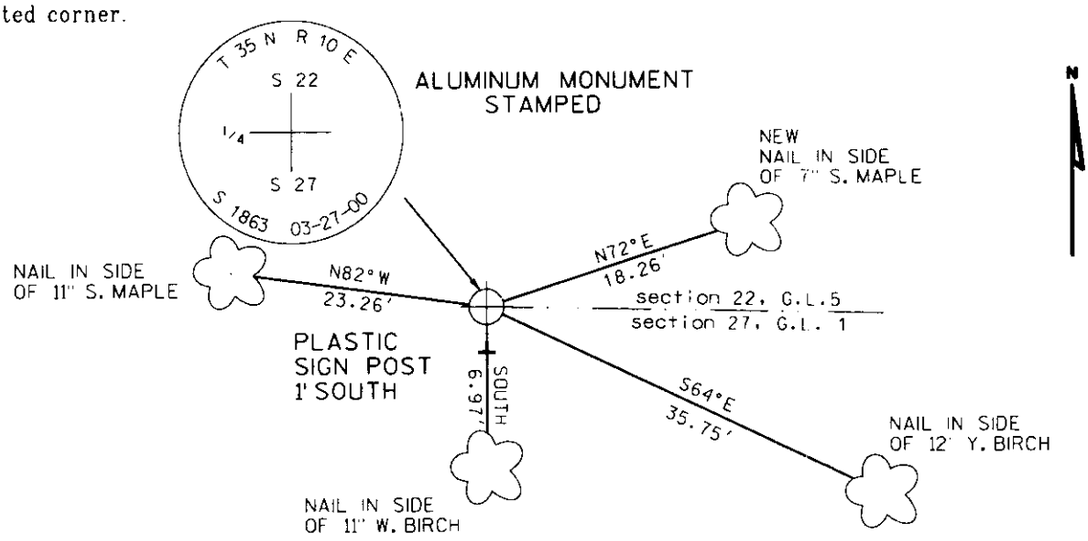

(i) I, Dennis B. Roberts, Registered Land Surveyor #S-1863, hereby certify that the corner location on this record was determined by me or under my direction and control and that this U.S. Public Land Survey Monument Record is correct and complete to the best of my knowledge and belief.

Dennis B. Roberts 8-22-2000

Signature Date

WISCONSIN DENNIS B. ROBERTS S-1863 RHINELANDER, WI 54501 LAND SURVEYOR

Index No. R-15

351022 0020