U.S. PUBLIC LAND SURVEY MONUMENT RECORD

Note: This form is intended and designed to fulfill all requirements of Wisconsin Administrative Code, Chapter A-E 7.08 U.S Public Land Survey Monument Record (3) (a) (b) (c) (d) (e) (f) (g) (h) (i). An additional sheet may be added if necessary t conform with said requirements.

(a) Corner location: Township 35 North

Range 10 East/~~West~~

Town/City/Village E. ENTERPRISE W. SCHOEPKE

County ONEIDA

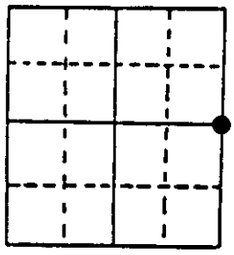

Section 25

(b) (f) (g) (h) Description of monument found at this corner and if it was accepted, state all evidence (material, testimonial, occupational, plats, records, other monuments) used as a basis for accepting. If not accepted or if nothing was found, state evidence used as basis for establishing location. If reestablished through lost corner proportionate methods, indicate all monuments, distances and directions used to establish. Indicate type of monument found or set and sign post.

1859 - H.C FELLOWS ESTABLISHED ORIGINAL CORNER.

1901 - B.F. DORR RECOVERED CORNER

1946 - LYTLE RECOVERED DORR'S POST DOWN & B.T. STUMP NE MADE NEW B.T. : 5" SPRUCE S 86°30'E, 18½ LKS.

1950 - F.R. WINCENTSEN INDICATES CORNER ON MAP # B 1383, ONEIDA CO. RECORDS.

1978 - Wm. BANDOW INDICATES CORNER AS FOUND BRASS CAPPED CONCRETE MONUMENT ON MAP # C 422, ONEIDA CO. RECORDS.

1990 - I FOUND 4x4 WOOD POST NEXT TO A BRASS CAPPED CONCRETE MONUMENT NORTH OF HWY. 45. BT'S WERE TAKEN OUT DURING CONSTRUCTION OF NEW HWY. 45. I STAMPED BRASS CAP AS CORNER & MADE 4 BT'S TO IT.

(c) (d) (e) Plan view of corner with ties to at least 4 witness monuments. If in disagreement with previously established corner, show the distances between the two corners and also indicate the ties to the disputed corner.

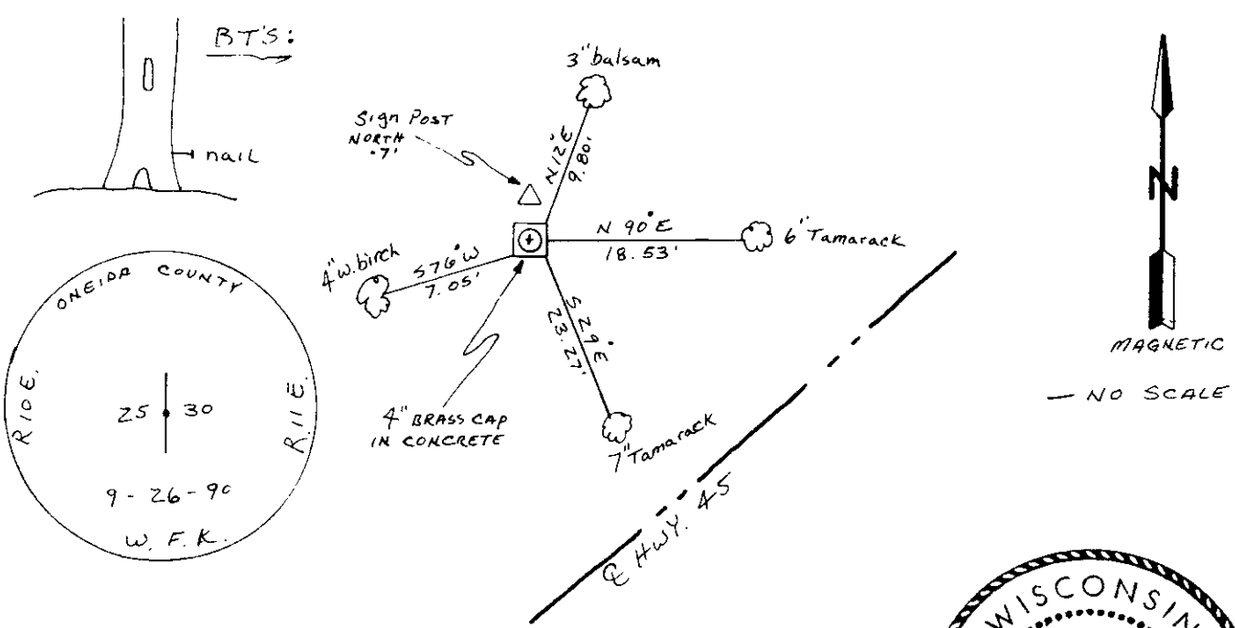

(i) I, WILLIAM F. KELLY (type or print name) certify that the corner location on this record was determined by me or under my direction and control and that this U.S. Public Land Survey Monument Record is correct and complete to the best of my knowledge and belief.

William F. Kelly 10-30-90

Signature Date

WISCONSIN WILLIAM F. KELLY S1098 ELCHO, WIS. LAND SURVEYOR

Index No. T-25

Stamp 3510252000