



U.S. PUBLIC LAND SURVEY MONUMENT RECORD

Note: This form is intended and designed to fulfill all requirements of Wisconsin Administrative Code, Chapter A-E 7.08 U.S. Public Land Survey Monument Record (3) (a) (b) (c) (d) (e) (f) (g) (h) (i). An additional sheet may be added if necessary to conform with said requirements.

(a) Corner location: Township 35 North
 Range 10 East/West

Town/City/Village E. ENTERPRISE W. SCHOEPEKE


County ONEIDA

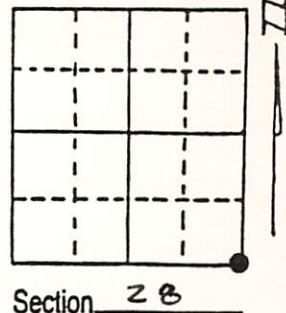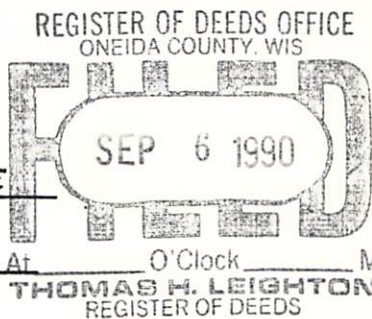

(b) (f) (g) (h) Description of monument found at this corner and if it was accepted, state all evidence (material, testimonial, occupational, plats, records, other monuments) used as a basis for accepting. If not accepted or if nothing was found, state evidence used as basis for establishing location. If reestablished through lost corner proportionate methods, indicate all monuments, distances and directions used to establish. Indicate type of monument found or set and sign post.


- 1865 - JAMES NOWLIN ESTABLISHED ORIGINAL CORNER
- 1896 - DORR MARKED NEW BEARING TREE
- 1902 - D. H. VAUGHAN USED CORNER
- 1978 - CORNER USED IN CONTROL FOR EAGLE LAKE WOODS SUB-DIVISION
- 1990 - I FOUND IRON UNDER SURFACE OF ROAD. SET R/R SPIKE OVER IRON & SET 3" AL. WITNESS MONUMENT WEST OF CORNER. SET POST NEXT TO AL. WIT. MONUMENT - MARKED BEARING TREES

(c) (d) (e) Plan view of corner with ties to at least 4 witness monuments. If in disagreement with previously established corner, show the distances between the two corners and also indicate the ties to the disputed corner.

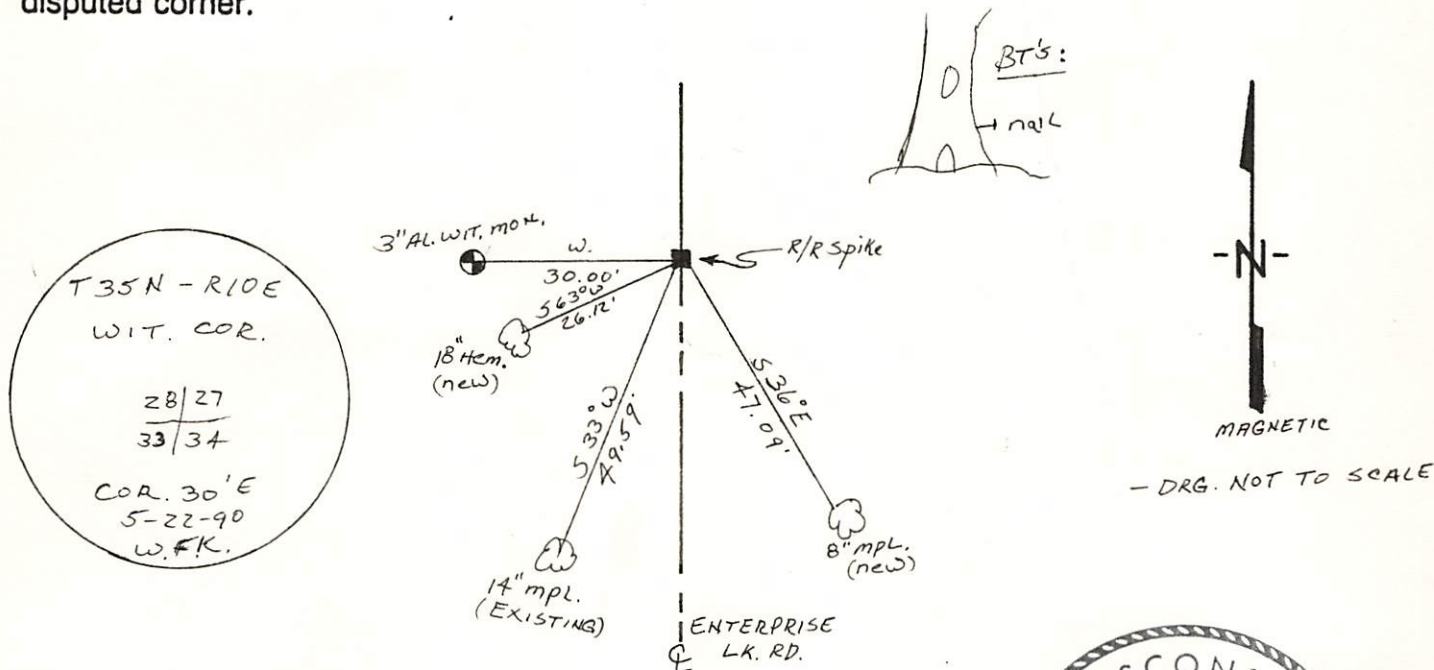

(i) I, WILLIAM F. KELLY
 (type or print name) certify that the corner location on this record was determined by me or under my direction and control and that this U.S. Public Land Survey Monument Record is correct and complete to the best of my knowledge and belief.

William F. Kelly
 Signature Date

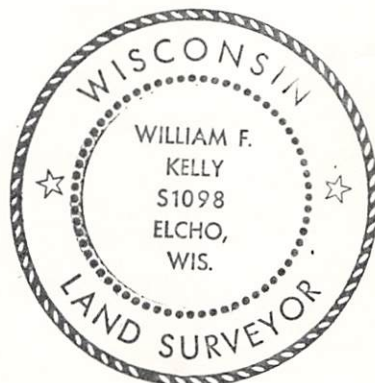

Index No. V-13

Stamp
 3510280000

FEB 08 2023


KYLE J. FRANSON
REGISTER OF DEEDS

U S PUBLIC LAND SURVEY MONUMENT RECORD - ADDENDUM

NOTE: This form is intended and designed to fulfill all requirements of Wisconsin Administrative Code, Chapter A-E 7.08 U.S. Public Land Survey Monument Record (3) (a-i)

A-E 7.08(3)(a) Identity of corner
SOUTHEAST CORNER OF SECTION 28
TOWNSHIP 35 NORTH
RANGE 10 EAST OF THE 4TH PM
TOWN OF ENTERPRISE,
COUNTY OF ONEIDA

WISCORS - ONEIDA COUNTY
N: 108,344.272 USft (108,344.290)
E: 308,853.664 USft (308,853.617)
Datum: NAD83 (2011)
GNSS Method RTN - Direct
GNSS Control WISCORS VRS

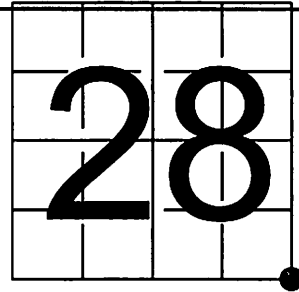

The coordinate value shown has been verified by the average of two or more GPS observations at a markedly different time. Values shown in parenthesis, are previously published measurements.

A-E 7.08(3)(b) Description of any record evidence, monument evidence, occupational evidence, testimonial evidence, or any other material evidence.

Original Surveyor: James L. Nowlin

Date of Original Survey	Commenced:	September 22, 1865	Original Accessories:
	Completed:	October 2, 1865	Sugar 18 N 45° W 25 Links
			Hemlock 24 N 31° E 40 Links

See Previous Monument Record: Index No. V-13 - May 22, 1990 - Surveyor 1098 - William F. Kelly - Thence:

April 3, 2000 - Surveyor 1795 - Devon Vanden Heuvel - indicates this position as "Exist. County Monument" on O.C.S. Map C1692.
October 25, 2001 - Surveyor 1451 - Eugene C. Uttech - indicates this position as "RR Spike found" on O.C.S. Map A3774.


July 21, 2022 - At the request of Oneida County Land Information, I found: Kelly's southeast B.T. and aluminum witness monument as shown on previous U.S. Public Land Survey Monument Record V-13.

I did not find Kelly's R.R. spike or the Railroad spike mentioned by any of the subsequent surveyor's.

A-E 7.08(3)(f) I restored this corner through ACCEPTANCE OF AN OBLITERATED LOCATION.

August 08, 2022 - I set a 2.5" long steel survey marker spike with a 1" diameter head and established 2 new witnesses as shown below.

A-E 7.08(3)(c)(d)(e)(h) Plan view of corner with references to at least 4 witness monuments. In if disagreement with previously established corner, show the distances between the two corners and also indicate the ties to the disputed. The directions and distances to other public land survey corners used as evidence or used for determining the corner location.

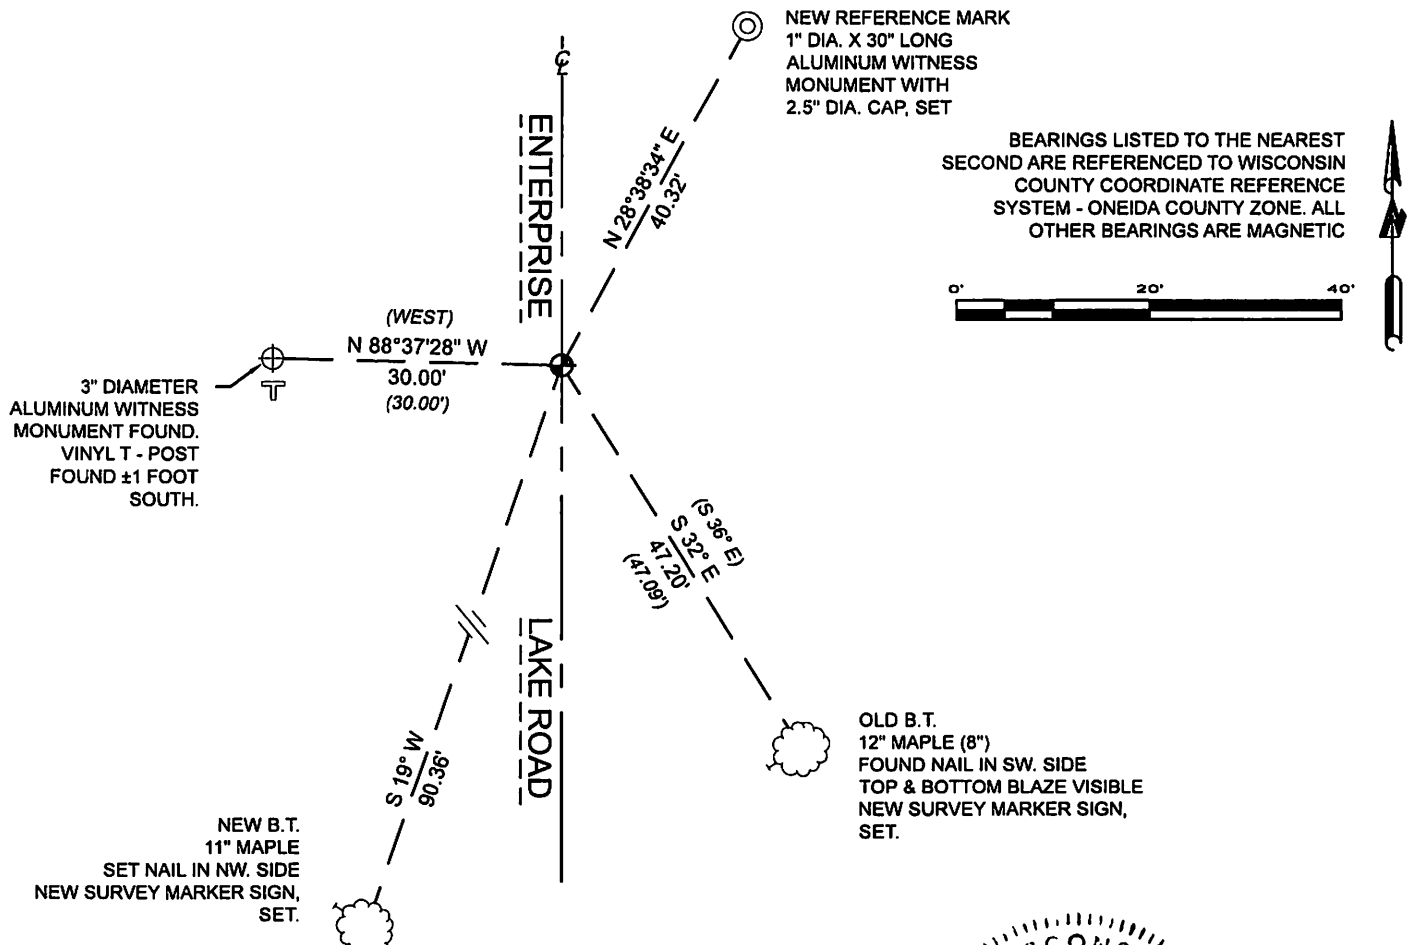


A-E 7.08(3)(i) I, Jeffrey L. DeMuth, Professional Land Surveyor No. S-2656, hereby certify that the corner location on this record was determined by me or under my direction and control and that this U.S. Public Land Survey Monument Record is correct and complete to the best of my knowledge, and belief

Handwritten signature of Jeffrey L. DeMuth

January 17, 2023
DATE

SIGNATURE

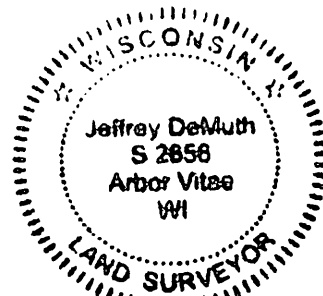

V-13
43510280000