



U.S. PUBLIC LAND SURVEY MONUMENT RECORD

Note: This form is intended and designed to fulfill all requirements of Wisconsin Administrative Code, Chapter A-E 7.08 U.S. Public Land Survey Monument Record (3) (a) (b) (c) (d) (e) (f) (g) (h) (i). An additional sheet may be added if necessary to conform with said requirements.

(a) Corner location: Township 35 North
 Range 10 East/West

Town/City/Village E. PELICAN W. SCHOEPEKE

County ONEIDA

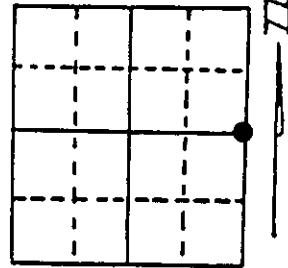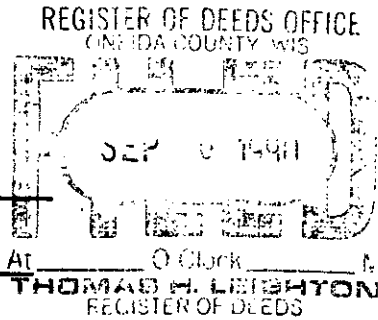

Section 28


(b) (f) (g) (h) Description of monument found at this corner and if it was accepted, state all evidence (material, testimonial, occupational, plats, records, other monuments) used as a basis for accepting. If not accepted or if nothing was found, state evidence used as basis for establishing location. If reestablished through lost corner proportionate methods, indicate all monuments, distances and directions used to establish. Indicate type of monument found or set and sign post.

1865 - JAMES NOWLIN ESTABLISHED ORIGINAL CORNER.

1990 - I FOUND 1" IRON ROD IN ROAD SET 3" AL. WIT. MONUMENT SE OF CORNER. SET 1" IRON PIPE WITNESS MON. AND ONEIDA COUNTY POST AT WIT. MON.

RESIDENT WITNESS (P. RIEGERT) IDENTIFIED LOCATION OF CORNER

(c) (d) (e) Plan view of corner with ties to at least 4 witness monuments. If in disagreement with previously established corner, show the distances between the two corners and also indicate the ties to the disputed corner.

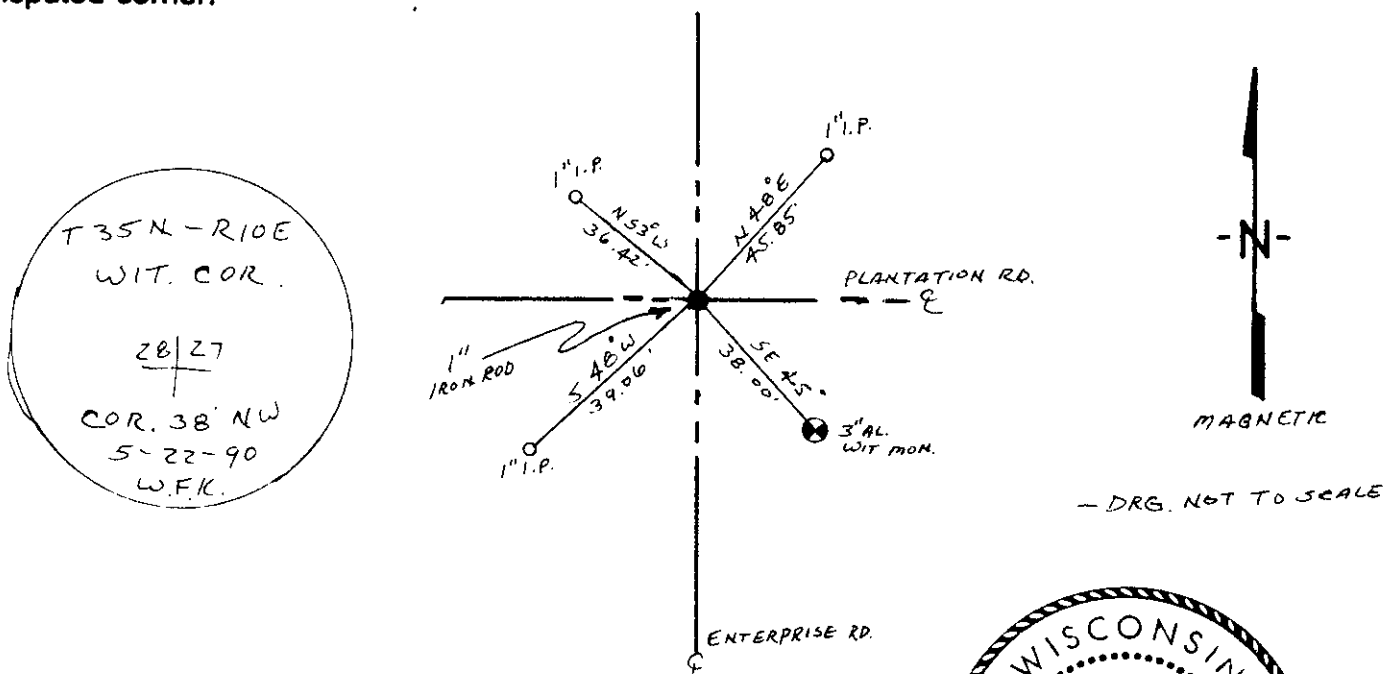

(i) WILLIAM F. KELLY
 (type or print name) certify that the corner location on this record was determined by me or under my direction and control and that this U.S. Public Land Survey Monument Record is correct and complete to the best of my knowledge and belief.



William F. Kelly 9-28-90
 Signature Date

Stamp

3510282000

Index No. F-13

U.S. PUBLIC LAND SURVEY MONUMENT RECORD


NOTE: This form is intended and designed to fulfill all requirements of Wisconsin Administrative Code, Chapter A-E 7 .08 U.S. Public Land Survey Monument Record (3)(a)(b)(c)(d)(e)(f)(g)(h)(i). An additional sheet may be added if necessary to conform with said requirements.

(a) Corner location: Township 35 North

Range 10 East

Town of Enterprise

County of Oneida

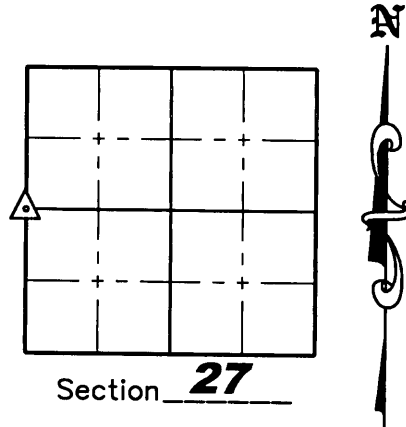

(b)(f)(g)(h) Description of monument found at this corner and if it was accepted, state all evidence (material, testimonial, occupation, plats, records, other monuments) used as a basis for accepting. If not accepted or if nothing was found, state evidence used as a basis for establishing location. If reestablished through lost corner proportionate methods, indicate all monuments, distances and directions used to establish. Indicate type of monument found or set and sign post.

September/October 1865 – James L. Nowlin set original 1/4 Section post; BT's: Sugar 20", S26°W, 4 links; Sugar 10", S16°E, 15 links

1990 – William F. Kelly Found 1" iron rod in road and set 3" Aluminum Witness Monument Southeast of corner. He also set 3 other 1" iron pipes as witness corners. Resident Witness (P. Riegert) identified location of corner.

September 14, 2000 – Kevin Bixby found a 1" iron rod per Plat of Survey (O.C.L.I.O. Map Number B4599).


May 20, 2008 – Matthew E. Hogle went to corner and found the 1" Iron Rod and the Southwesterly and Southeasterly witness corners set by William Kelly in 1990. We set a P.K. Nail on the surface and witnessed the corner as shown hereon.

(c)(d)(e) Plan view of corner with ties to at least 4 witness monuments. If in disagreement with previously established corner, show the distances between the two corners and also indicate the ties to the disputed corner.

Scale 1" = 50'


Legend

- △ P.K. Nail Set over 1" Iron Rod
- 3/4" x 24" Iron Rebar Set Weighing 1.50 lbs/lin ft.
- 1" Iron Pipe Found
- ⊕ Found 3" Aluminum Witness Monument
- Found 3" Cap in Concrete/U.S.G.S. Bench Mark 1939

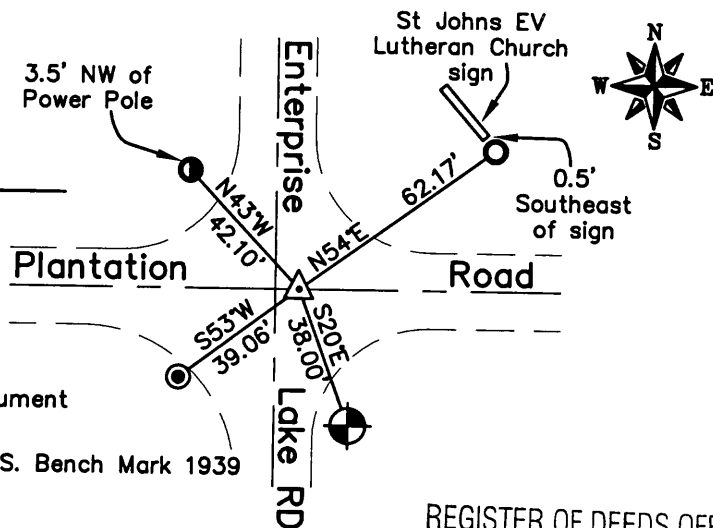

(i) I, Matthew E. Hogle, certify that the corner location on this record was determined by me under my direction and control and that this U.S. Public Land Survey Monument is correct and complete to the best of my knowledge and belief.

Signature Matthew E. Hogle Date 5/27/08
 3510282000

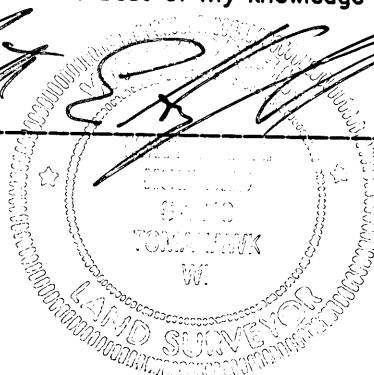

REGISTER OF DEEDS OFFICE
ONEIDA COUNTY, WIS.

JUN 11 2008

At _____ O'Clock _____ M
 THOMAS H. LEIGHTON
 REGISTER OF DEEDS

INDEX T-13

FEB 08 2023


KYLE J. FRANSON
REGISTER OF DEEDS

U S PUBLIC LAND SURVEY MONUMENT RECORD - ADDENDUM

NOTE: This form is intended and designed to fulfill all requirements of Wisconsin Administrative Code, Chapter A-E 7.08 U.S. Public Land Survey Monument Record (3) (a-i)

A-E 7.08(3)(a) Identity of corner
EAST 1/4 CORNER OF SECTION 28
TOWNSHIP 35 NORTH
RANGE 10 EAST OF THE 4TH PM
TOWN OF ENTERPRISE,
COUNTY OF ONEIDA

WISCRS - ONEIDA COUNTY
N: 110,971.798 USft (110,971.747)
E: 308,829.427 USft (308,829.462)
Datum: NAD83 (2011)
GNSS Method RTN - Direct
GNSS Control WISCORS VRS

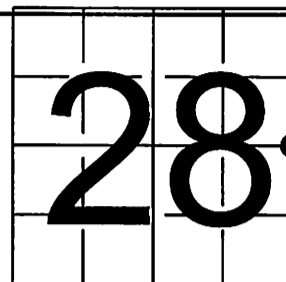

The coordinate value shown has been verified by the average of two or more GPS observations at a markedly different time. Values shown in parenthesis, are previously published measurements.

A-E 7.08(3)(b) Description of any record evidence, monument evidence, occupational evidence, testimonial evidence, or any other material evidence.

Original Surveyor: James L. Nowlin

Date of Original Survey	Commenced:	September 22, 1865	Original Accessories:			
	Completed:	October 2, 1865	Sugar	20	N 26° W	4 Links
			Sugar	10	S 16° E	15 Links

See Previous Monument Record: Index No. T-13 - May 20, 2008 - Surveyor 1910 - Matthew E. Hoglund - Thence:

July 31, 2015 - Surveyor 1523 - Todd J. Loftus - indicates this position as "P.K. nail/Found Subdivisional monument of record" on O.C.S. Map B7806.


July 21, 2022 - At the request of Oneida County Land Information, I found: 3 of Hoglund's witness monuments as shown on previous U.S. Public Land Survey Monument Record T-13, as well as 2 - 0.75" diameter iron pipe monuments by Todd J Loftus from O.C.S Map B4318, and 1 - 3.5" diameter brass capped, concrete USGS monument.

I did not find the P.K. nail set by Hoglund and mentioned by any of the subsequent surveyor's.

A-E 7.08(3)(f) I restored this corner through ACCEPTANCE OF AN OBLITERATED LOCATION.

August 8, 2022 - I set a 2.5" long steel survey marker spike with a 1" diameter head and established 3 new witnesses as shown below. Monument is ±1' south of Plantation Road centerline, and ±5' east of Enterprise Lake Road centerline.


A-E 7.08(3)(c)(d)(e)(h) Plan view of corner with references to at least 4 witness monuments. If in disagreement with previously established corner, show the distances between the two corners and also indicate the ties to the disputed. The directions and distances to other public land survey corners used as evidence or used for determining the corner location.

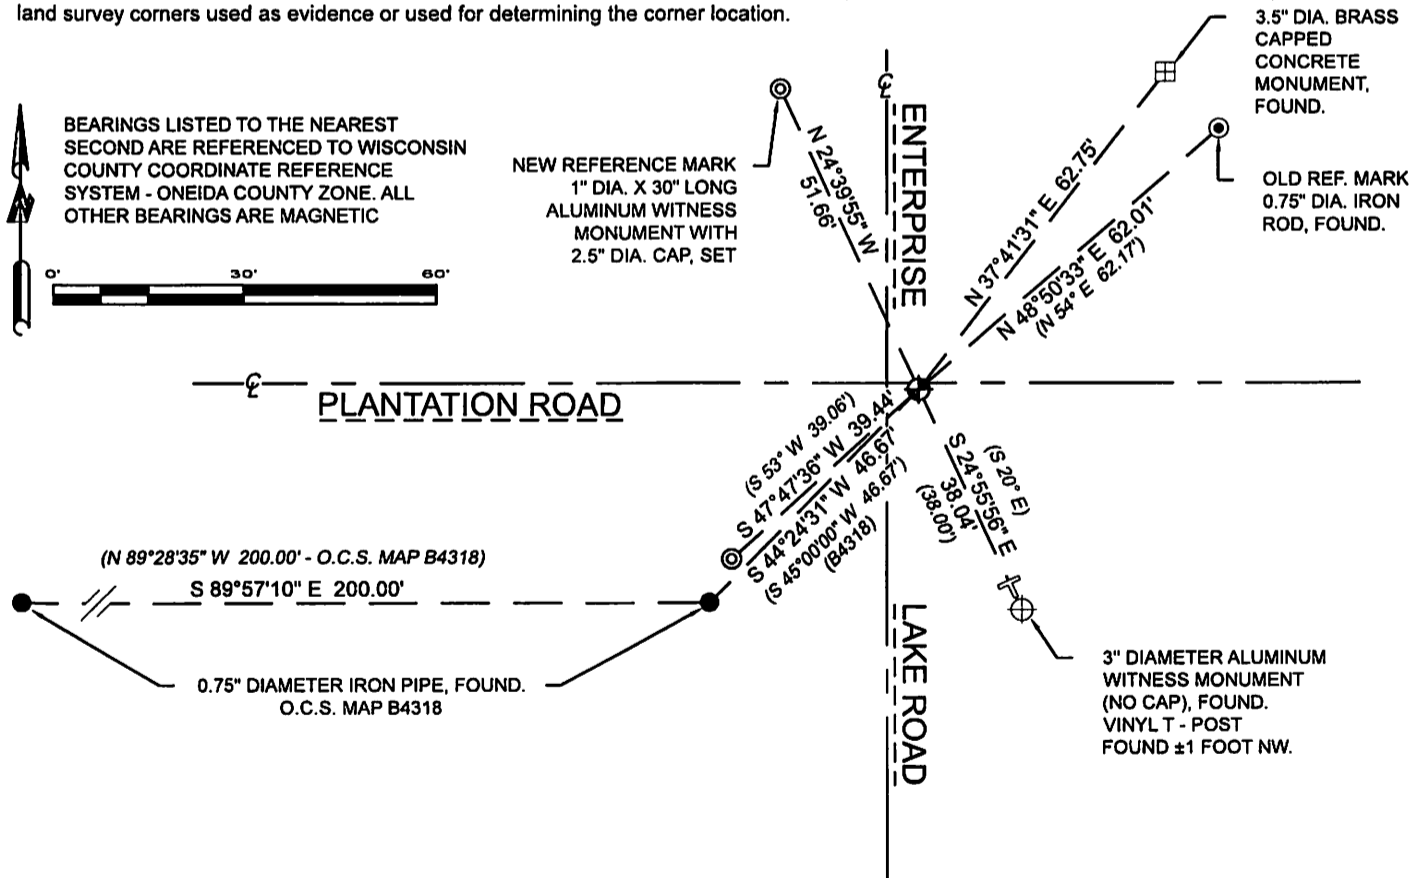

A-E 7.08(3)(i) I, Jeffrey L. DeMuth, Professional Land Surveyor No. S-2656, hereby certify that the corner location on this record was determined by me or under my direction and control and that this U.S. Public Land Survey Monument Record is correct and complete to the best of my knowledge, and belief

January 17, 2023
DATE

SIGNATURE

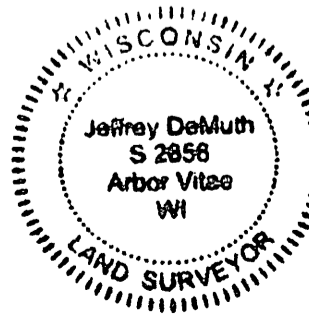

T-13
43510282000