

State of Wisconsin }
 County of Lanplade } ss.

I Raymond J. Hally, do hereby certify that on the 6th day of December, 1981, I found evidence of the West 1/16 corner of Section 31 & 6 Township T33NR10E, North, Range T33PR10E, Fourth Principal Meridian, as described hereon; and that from this evidence I established a new monument and accessories as described hereon to perpetuate the original location of this corner.

Resident witnesses:

CERTIFIED LAND CORNER RESTORATION

History of original corner establishment:

Corner set in the 1930 resurvey.

Copy from Lanplade CT.

Index No. 4-2

3510
3510



Description of corner evidence found:

Found stake standing, marked W1/8 6, 31
 1d Pt 6 Red Pine W 8 1/2 2.7 Ft.

Description of monument and accessories I established to perpetuate the original location of this corner.

Set 1 1/2" Iron Pipe with brass cap
 New Pt's

8"	Hemlock	56W	9.3 Ft.
5"	Hemlock	52NW	10.8 Ft.
7"	Red Pine	56SW	9.3 Ft.

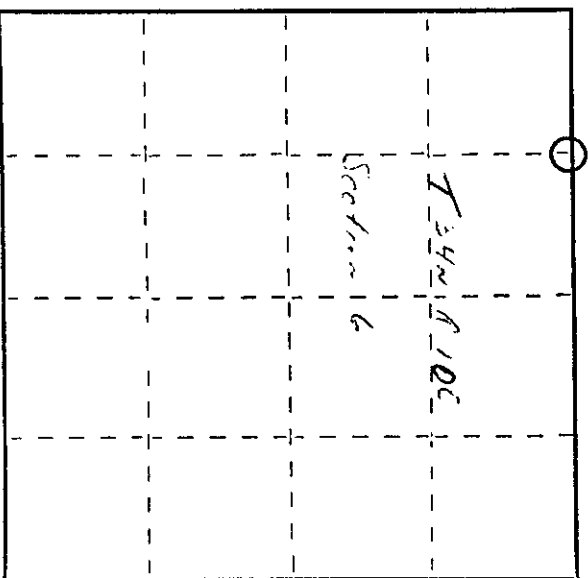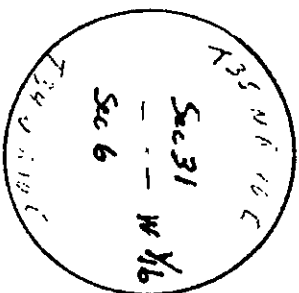

○ = Corner monument restored.

Dated at Antigo, Wis., this 6th day of December, 1981.

Signature Raymond J. Hally Title Land Surveyor Registration No. S-685
 (County Surveyor, Registered Land Surveyor, or other duly authorized official)

Office of Registrar of Deeds, County of _____, I hereby certify that the within instrument was filed in this office for record on the _____ day of _____, 19____ at _____ o'clock _____ M.

(Register of Deeds)

By _____ Deputy