

CERTIFIED LAND CORNER RESTORATION

History of original corner establishment:

State of Wisconsin }



Resident witnesses:

Index No. 35-10

2-21


35-10
 COPY FROM

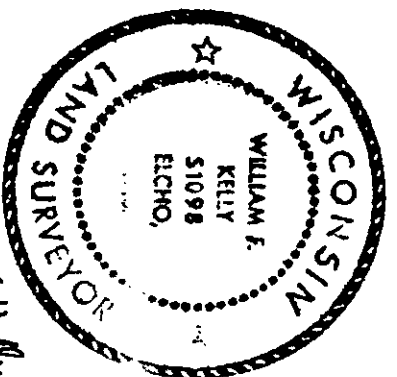

William F. Kelly


Description of corner evidence found:

FOUND WITNESS CORNER MARKED:
 LOCATED OLD B.T. WITH BLAZE AT BASE.

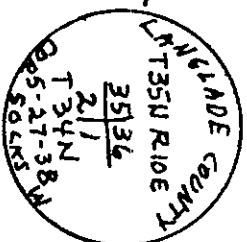

Description of monument and accessories I established to perpetuate the original location of this corner.

QRT 20" HEMLOCK (B.T.)

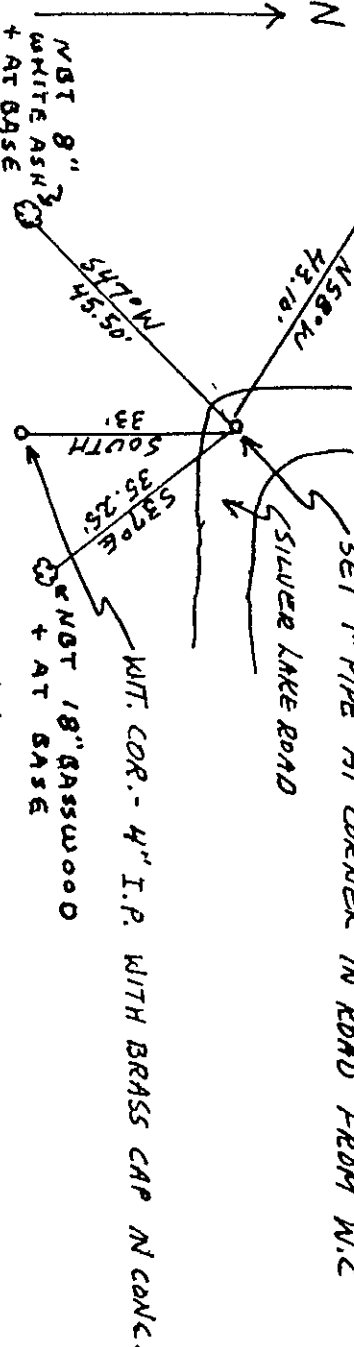


Dated at ELCHO, Wis., this 24TH day of NOVEMBER, 1975.

Signature William F. Kelly Title REGISTERED LAND SURVEYOR Registration No. 51098
 (County Surveyor, Registered Land Surveyor, or other duly authorized official)


(Register of Deeds)

By: _____ Deputy

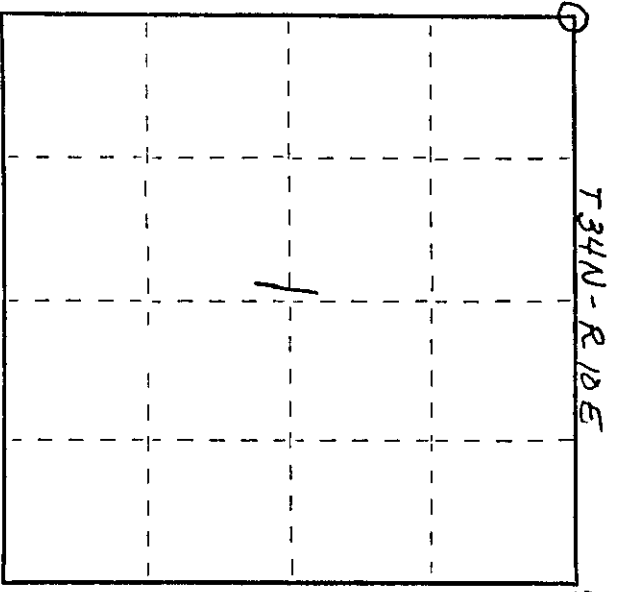

○ = Corner monument restored.