

CERTIFIED LAND CORNER RESTORATION

34-10

Index No. **A-20**
 Z-20
 35-10

COPY FROM
 LANDLORD CITY

State of Wisconsin }

I, Edward J. Mulvey, do hereby certify that on the 22 day of June, 1928, I found evidence of the 1/16 corner of the Section 2 Township 34, North, Range 10, Fourth, Principal Meridian, as described hereon; and that from this evidence I established a new monument and accessories as described hereon to perpetuate the original location of this corner.

Resident witnesses:

History of original corner establishment:


Description of corner evidence found:


Four squared stakes, rock mound, marked 1/16 22 35

Description of monument and accessories I established to perpetuate the original location of this corner.

Set with 1 1/2" pipe with cap marked 1/16 2 35

of 10" pipe
Nov 9 '15"

of 8" white brick
Set Nov 14'

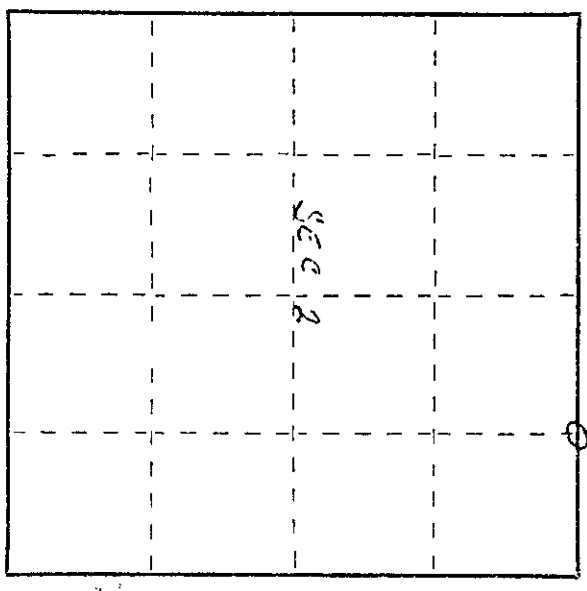

○ = Corner monument restored.

Dated at Little, Wis., this 8th day of June, 1928.
 Signature Edward J. Mulvey Title Reg. Land Surveyor Registration No. 1-685
 (County Surveyor, Register of Land Surveyors, or other duly authorized official)
 Instrument was filed in this office for record on the 22 day of June, 1928 at 11 o'clock AM.

(Register of Deeds)

By _____ Deputy